

JACKSON

J 2058

MISSISSIPPI BOARD OF WATER COMMISSIONERS
416 North State Street
Jackson, Mississippi 39201

WATER WELL DRILLERS LOG

5-12-1978 date well completed
Coast Water Well Serv. Inc. firm name
Jackson county well located

LANDOWNER: Ray Jordan
P.O. Box 583,
Ocean Springs, Miss 37533
(mailing address)

WELL LOCATION:
sec 14 T 6 S R 9 W
7 miles N. of Ocean Springs
(distance) (direction) (nearest town)

WELL PURPOSE: home
(home, irrigation, municipal, industrial)

WELL COMPLETION DATA:
(1) diameter (inches) 2"
(2) total depth (feet) 415'
(3) static water level (feet) 50' below above top of ground.
(4) casing PVC, 405'
(material) (depth)
2" if telescope see back.
(size)
(5) screen 10', 405'
(length) (depth to top)
2", PVC
(size) (material)
(6) pump 1hp, 8
(HP) (yield gpm)
Elec.
(type power)
(7) electric log No
(yes or no)
(organization running log)

(8) how well bottom plugged
Backwash Valve

DRILLERS REMARKS:


description of formations encountered	from	to
Top soil	0	5
Red Clay	5	18
Sand (m)	18	25
Blue Clay	25	140
Sand (mc)	140	210
Blue Clay	210	375
Sand (F)	375	390
Sand (mc)	390	415

RECEIVED
AUG - 4 1978

MISS. BD. OF WATER COMM

If well telescopes please sketch and show depths.

GROUND LEVEL

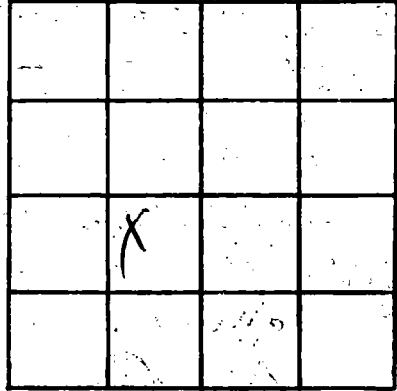

SECTION 14

Please indicate well location X.

ADDITIONAL INFORMATION

If more than one screen, show locations of each on sketch.