

JACKSON

J 2059

7/11/78

7/11/78
date well completed

MISSISSIPPI
BOARD OF WATER COMMISSIONERS
416 North State Street
Jackson, Mississippi 39201

WATER WELL DRILLERS LOG

Coastal Drilling Jackson
Bilal's Min firm name county well located

LANDOWNER: Pat Adams Jr

Rt 5 Box 213 E

Ocean Springs Min
(mailing address)

WELL LOCATION:

sec 24 T 9N R 9W
Latimer of ?
(distance) (direction) (nearest town)

WELL PURPOSE: home
(home, irrigation, municipal, industrial)

WELL COMPLETION DATA:

- (1) diameter (inches) 2"
- (2) total depth (feet) 440'
- (3) static water level (feet) 55 below above top of ground.
- (4) casing PVC 430'
(material) (depth)
2" If telescope see back.
(size)
- (5) screen 10' 430'
(length) (depth to top)
2" PVC
(size) (material)
- (6) pump one 12
(HP) (yield gpm)
3/4"
(type power)
- (7) electric log no
(yes or no)

(organization running log)

(8) how well bottom plugged

3" backfilled with blue

DRILLERS REMARKS:

description of formations encountered

from to

Top Soil	1	4
Red Clay	4	25
White Sand	25	70
5 ft Blue Clay	70	210
Free Water Sand	210	235
Hard Blue Clay	235	440
Case Water Seal	440	440


RECEIVED

JUL 18 1978

MISS. BD. OF WATER COMM

If well telescopes please sketch and show depths.

GROUND LEVEL

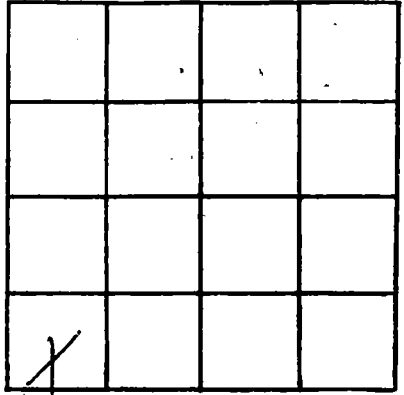

SECTION _____

Please indicate well location X.

ADDITIONAL INFORMATION

If more than one screen,
show locations of each on sketch.