

JACKSON
 J 200
 8-3-78

MISSISSIPPI
 BOARD OF WATER COMMISSIONERS
 416 North State Street
 Jackson, Mississippi 39201

WATER WELL DRILLERS LOG

8-3-78 19 SWITZER WELL CO. JACKSON
 date well completed firm name county well located

ANTHONY O. SKINNER

LANDOWNER: MRS. BOB SMEE
15713 Little Joe Rd.
Biloxi, MS. 39530
 (mailing address)

description of formations encountered	from	to
clay	0	24
sand & gravel	24	56
clay	56	64
sand & gravel	64	99
clay	99	216
sand	216	222
clay	222	368
sand	368	421

WELL LOCATION:
 sec. 34 T-6 N R-9 E
3 1/2 miles N of ST. MARTIN
 (distance) (direction) (nearest town)

WELL PURPOSE: Home
 (home, irrigation, municipal, industrial)

- WELL COMPLETION DATA:
- diameter (inches) 2"
 - total depth (feet) 421'
 - static water level (feet) 49' ^{below} above top of ground.
 - casing STEEL 401'
 (material) (depth)
2" if telescope see back.
 (size)
 - screen 20' 401'
 (length) (depth to top)
2" Stainless WRAPIED EDV.
 (size) (material)
 - pump 1 12
 (HP) (yield gpm)
AC
 (type power)
 - electric log NO
 (yes or no)
 (organization running log)
 - how well bottom plugged METAL
BACKWASH VALVE

RECEIVED


AUG 22 1978

DRILLERS REMARKS:

MISS. BD. OF WATER COMM

If well telescopes please sketch and show depths.

GROUND LEVEL

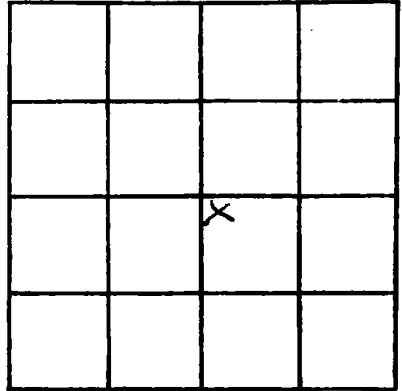

SECTION 34

Please indicate well location X.

ADDITIONAL INFORMATION

If more than one screen, show locations of each on sketch.