

JACKSON
 J 2062
 9-09-78

MISSISSIPPI
 BOARD OF WATER COMMISSIONERS
 416 North State Street
 Jackson, Mississippi 39201

WATER WELL DRILLERS LOG

9/9 1978 78 Duncan Well Drilling Jackson
 date well completed firm name county well located

LANDOWNER: Ernest V. Alexander
10000 Tucker Rd.
Ocean Springs, Ms.
 (mailing address)

WELL LOCATION:
 sec 26 T 6 N R 9 E
3 1/2 miles S of Latimer
 (distance) (direction) (nearest town)


WELL PURPOSE: Home
 (home, irrigation, municipal, industrial)

WELL COMPLETION DATA:
 (1) diameter (inches) 2"
 (2) total depth (feet) 400
 (3) static water level (feet) 45' below/above top of ground.
 (4) casing PVC, 410
 (material) (depth)
10' If telescope see back.
 (size)
 (5) screen 10', 410
 (length) (depth to top)
2", PVC
 (size) (material)
 (6) pump 1 11
 (HP) (yield gpm)
electric
 (type power)
 (7) electric log
 (yes or no)

 (organization running log)

Description of formations encountered	from	to
Clay	0	8
sand	8	60
white clay	60	150
fine sand	150	180
blue clay	180	365
fine sand	365	410
coarse sand	410	420

DRILLERS REMARKS:
how well bottom plugged sand
shank

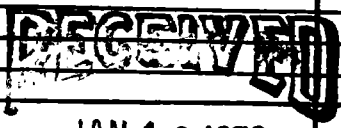


JAN 10 1978

MISS. BD. OF WATER COMMISSIONERS

If well telescopes please sketch and show depths.

GROUND LEVEL

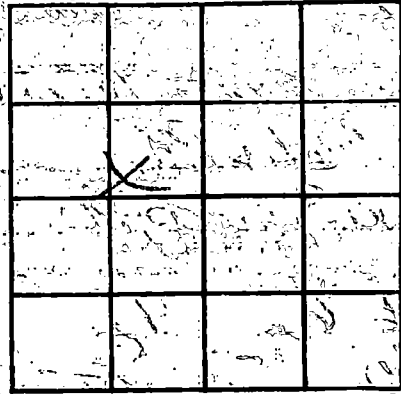

SECTION 26

Please indicate well location X.

ADDITIONAL INFORMATION

If more than one screen, show locations of each on sketch.