

Jackson
 J 2068
 11-7-78

MISSISSIPPI
 BOARD OF WATER COMMISSIONERS
 416 North State Street
 Jackson, Mississippi 39201

WATER WELL DRILLERS LOG

11-7-1978 date well completed
 Coast Water Well Serv. Inc. firm name
 Jackson county well located

LANDOWNER	description of formations encountered	from	to
John Messing	Topsoil + Red Clay	0	10
Pl 1 - Box 48	Red Med. Sand	10	26
Ocean Springs, Miss. (mailing address) 31564	Blue Clay	26	375
	Grey Coarse sand	375	399

WELL LOCATION:

sec. 24 T. 6 R. 9
 4 miles North of Ocean Springs
 (distance) (direction) (nearest town)

WELL PURPOSE: home
 (home, irrigation, municipal, industrial)

WELL COMPLETION DATA:

- (1) diameter (inches) 2"
- (2) total depth (feet) 399
- (3) static water level (feet) 32' below top of ground
- (4) casing PVC 389' (material) (depth)
 2" (size) If telescope see back.
- (5) screen 10' 389' (length) (depth to top)
 2" (size) PVC (material)
- (6) pump 1/2 HP 9- (type power) (yield gpm)
- (7) electric log No. (yes or no)

(organization running log)

(8) Is well bottom plugged? Backwash valve

DRILLERS REMARKS:


Miss. Board of Water Comm.

MAY 29 1979

RECEIVED

If well telescopes please sketch and show depths.

GROUND LEVEL

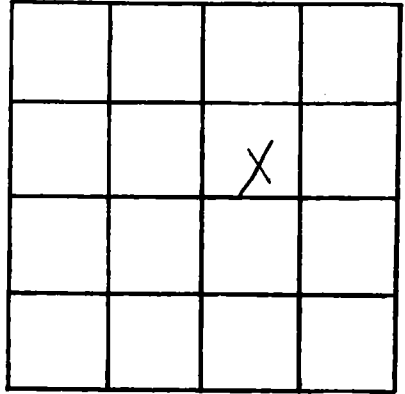

SECTION 24

Please indicate well location X.

ADDITIONAL INFORMATION

If more than one screen,
show locations of each on sketch.