

JACKSON
 J 2069
 11-10-78


MISSISSIPPI
 BOARD OF WATER COMMISSIONERS
 416 North State Street
 Jackson, Mississippi 39201

WATER WELL DRILLERS LOG

11-10-1978 date well completed
 28 Coast Water Well Service, Inc. firm name
 Jackson county well located

LANDOWNER	description of formations encountered	from	to
Albert Leary 6305 North Washington Ocean Springs, Miss. (mailing address) 39564	Top soil + red clay	0	10
	Blue Clay	10	60
	Gray Coarse sand	60	70
	Blue Clay	70	150
	Gray Coarse sand	150	170
	Blue Clay	170	194
	Gray med. fine sand	194	213
	Blue Clay	213	483
	Blue Clay + streak of sand	483	497
	Blue clay	497	686
	Gray Coarse sand	686	710

WELL LOCATION:

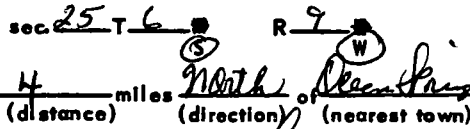

WELL PURPOSE: None
 (home, irrigation, municipal, industrial)

WELL COMPLETION DATA:

- (1) diameter (inches) 2"
- (2) total depth (feet) 710'
- (3) static water level (feet) 20' below top of ground.
- (4) casing PVC 400' (material) (depth)
- 2" (size) If telescope see back.
- (5) screen 10' 700' (length) (depth to top)
- 2" PVC (size) (material)
- (6) pump 1 hp. (HP) (yield gpm)
- Elect. (type power)
- (7) electric log No- (yes or no)
- (organization running log)

(8) How well bottom plugged
 backwash valve

DRILLERS REMARKS:

Miss. Board of Water Comm.

MAY 29 1979

RECEIVED

If well telescopes please sketch and show depths.

GROUND LEVEL

		X	

SECTION 25

Please indicate well location X.

ADDITIONAL INFORMATION

If more than one screen, show locations of each on sketch.