

JACKSON

J 2074

1-20-79

1/20/79

date well completed

MISSISSIPPI BOARD OF WATER COMMISSIONERS 416 North State Street Jackson, Mississippi 39201

WATER WELL DRILLERS LOG

COASTAL DRILLING & SERVICE Jackson

ROUTE name BOX 618

county well located

LANDOWNER: Mike Singleton

DESCRIPTION OF FORMATIONS encountered

from to

from to

Rt 6 Box 102

top soil 1 3

Ocean Springs Miss (mailing address)

Red Clay 3 15

WELL LOCATION:

sec 36 T 6 R 9 (distance) (direction) (nearest town)

Coarse white sand 15 60

Soft blue clay 60 270

hard blue clay 270 400

fine water sand 400 430

top soil 430 435

hard blue clay 435 610

fine water sand 610 640

Coarse water sand 640 670

WELL PURPOSE: home (home, irrigation, municipal, industrial)

WELL COMPLETION DATA:

- (1) diameter (inches) 2"
(2) total depth (feet) 670'
(3) static water level (feet) 30' below top of ground.
(4) casing PVC, 660' (depth)
(5) screen 10' (length), 660' (depth to top)
(6) pump One (HP), 14 (yield gpm)
(7) electric log no

(organization running log)

(8) how well bottom plugged 2" broken blue

DRILLERS REMARKS: 19-B

Miss. Board of Water Comm


MAY 16 1979

RECEIVED

If well telescopes please sketch and show depths.

GROUND LEVEL

Notes of flow

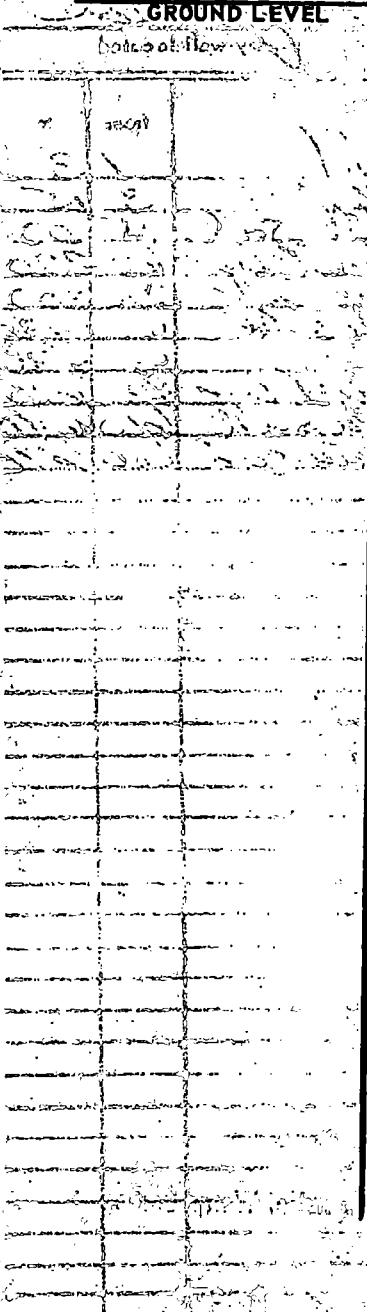

If more than one screen, show locations of each on sketch.



SECTION _____

Please indicate well location X.

ADDITIONAL INFORMATION

Multiple horizontal lines for recording additional information, with some faint handwritten notes.