

Jackson  
5 20787  
4-2-79

MISSISSIPPI  
BOARD OF WATER COMMISSIONERS  
416 North State Street  
Jackson, Mississippi 39201

WATER WELL DRILLERS LOG

4-2-79 date well completed Coast Water Well Serv Inc. firm name Jackson county well located

LANDOWNER: Tracy Webb

description of formations encountered

from

to

Box 57K  
Ocean Springs, Miss  
(mailing address) 3264

Top Soil

0

3

Red Clay

3

23

Sand-gray Clay

23

47

Blue Clay

47

70

Sand (m)

70

140

Blue Clay

140

175

Sand (m)

175

205

WELL LOCATION:

sec. 24 T. 6 N. R. 9 E.  
4 miles North Ocean Springs  
(distance) (direction) (nearest town)

WELL PURPOSE:

(home, irrigation, municipal, industrial)

WELL COMPLETION DATA:

(1) diameter (inches) 2"

(2) total depth (feet) 205'

(3) static water level (feet) 25' below  
top of ground above

(4) casing PVC, 195'  
(material) (depth)

2"  
(size) If telescope see back.

(5) screen 10', 195'  
(length) (depth to top)

2", PVC  
(size) (material)

(6) pump 1 h.p., 8-  
(H.P.) (yield gpm)

Electric  
(type power)

(7) electric log No.  
(yes or no)

(organization running log)

(8) how well bottom plugged  
back wash valve

DRILLERS REMARKS:


Miss. Board of Water Comm.

MAY 29 1979

RECEIVED

If well telescopes please  
sketch and show depths.

GROUND LEVEL

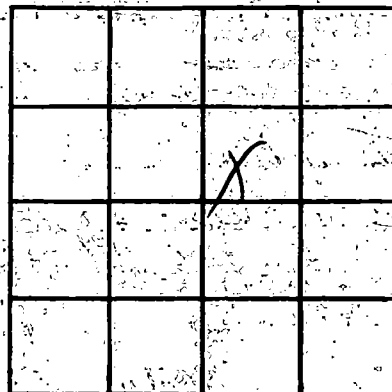

SECTION 24

Please indicate well location X.

ADDITIONAL INFORMATION

If more than one screen,  
show locations of each on sketch.