

JACKSON
 J 2078
 4-3-79

MISSISSIPPI
 BOARD OF WATER COMMISSIONERS
 416 North State Street
 Jackson, Mississippi 39201

WATER WELL DRILLERS LOG
 COASTAL DRILLING & SERVICE CO.

01/3/79
 date well completed 19

ROUTE 1 BOX 618
 firm name
 JACKSON
 county well located
 MOXI, MISS. 39532

LANDOWNER: Elton Gallett
Camp McClure Coal
Biladi Min
 (mailing address)

description of formations encountered	from	to
top soil	1	3
white sand	3	15
yellow sand	15	25
soft blue clay	45	90
yellow sand	90	120
loam	120	225
soft blue clay	125	280
hard blue clay	280	400
fine water sand	400	420
coarse water sand	420	450

WELL LOCATION:
 sec 35 T 6 N R 9 E
 (distance) (direction) (nearest town)
(2) 1/2 miles south of Latimer

WELL PURPOSE: home
 (home, irrigation, municipal, industrial)

- WELL COMPLETION DATA:
- (1) diameter (inches) 2"
 - (2) total depth (feet) 450'
 - (3) static water level (feet) 45' below top of ground
 - (4) casing PVC, 440' (material) (depth)
 - _____ If telescope see back. (size)
 - (5) screen 10', 440' (length) (depth to top)
 - 2" (size), PVC (material)
 - (6) pump one, 13 (HP) (yield gpm)
 - 5hp (type power)
 - (7) electric log no (yes or no)
 - _____ (organization running log)

(8) how well bottom plugged
2nd pack with gravel

DRILLERS REMARKS:


Miss. Board of Water Comm.

JUN 15 1979

RECEIVED

If well telescopes please sketch and show depths.

GROUND LEVEL

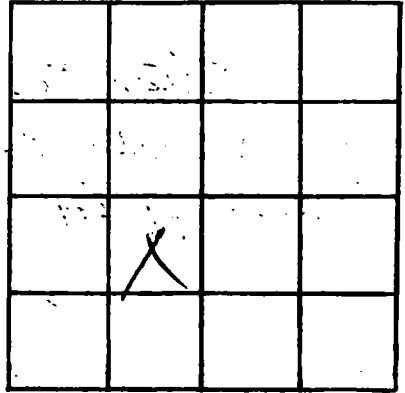

SECTION _____

Please indicate well location X.

ADDITIONAL INFORMATION

Multiple horizontal lines for additional information, with a handwritten signature at the bottom.

If more than one screen, show locations of each on sketch.