

New work Well

Jackson
J 2080
4-20-79

MISSISSIPPI
BOARD OF WATER COMMISSIONERS
416 North State Street
Jackson, Mississippi 39201

WATER WELL DRILLERS LOG

4-20 1979 *Coast Water Well Dr. Inc. - Jackson*
date well completed firm name county well located

LANDOWNER: <i>Joe Evans</i>	description of formations encountered	from	to
10329 <i>Old Id. Bayou Rd.</i>			
<i>Ocean Springs, Miss.</i>	Top soil	0	5
(mailing address) <i>3164</i>	Red Clay	5	20
	Back of	20	30
	Red Clay	20	21
WELL LOCATION:	Red fine sand	21	68
sec <i>26 T 6 S R 8 W</i>	Blue Clay	68	124
<i>5</i> miles <i>N. East</i> of <i>Ocean Springs</i>	Gray fine sand	124	183
(distance) (direction) (nearest town)	Blue Clay	183	249
WELL PURPOSE: <i>Home -</i>	Blue fine sand	249	253
(home, irrigation, municipal, industrial)	Blue Clay + Chert shell	253	330
	White Coarse sand	330	379
WELL COMPLETION DATA:	Blue Clay + Chert shell	379	490
(1) diameter (inches) <i>2"</i>	Gray Coarse sand	490	558
(2) total depth (feet) <i>558'</i>			
(3) static water level (feet) <i>38'</i> below top of ground			
(4) casing <i>P.V.C.</i> <i>548'</i>			
(material) (depth)			
<i>2"</i> If telescope see back.			
(size)			
(5) screen <i>10'</i> <i>548'</i>			
(length) (depth to top)			
<i>2"</i> <i>P.V.C.</i>			
(size) (material)			
(6) pump <i>1 hp.</i> <i>10</i>			
(HP) (yield gpm)			
<i>Elect.</i>			
(type power)			
(7) electric log <i>no -</i>			
(yes or no)			
(organization running log)			
(8) how well bottom plugged <i>Back Wash Valve</i>			

Miss. Board of Water Comm.


DRILLERS REMARKS:

MAY 29 1979

RECEIVED

If well telescopes please sketch and show depths.

GROUND LEVEL

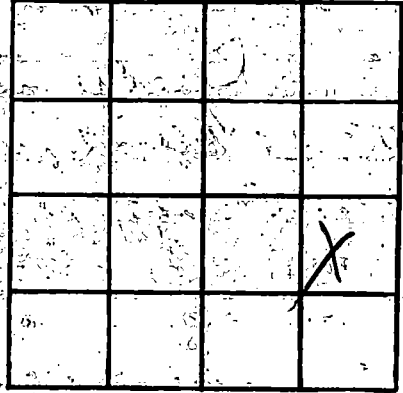

SECTION 26

Please indicate well location X.

ADDITIONAL INFORMATION

If more than one screen, show locations of each on sketch.