

MISSISSIPPI DEPARTMENT OF NATURAL RESOURCES

Bureau of Land and Water Resources

Southport Mall

P.O. Box 10631

Jackson, Mississippi 39209

WATER WELL DRILLERS LOG

COASTAL DRILLING & SERVICE CO. *Jackson*

ROUTE 1 BOX 618

firm name

county well located

DILOXI, MISS. 39532

JACKSON
J 2084
7-6-79

7/16/79
date well completed

LANDOWNER: *Charles Orville*

description of formations encountered

from to

Senon Rd

top soil

1 3

Oliver Boring Min
(mailing address)

red clay

3 18

WELL LOCATION:

sec. *35* T. *5* N. R. *9* E.
(distance) (direction) (nearest town)
(2) miles S.E. of Joliver

Super Sand

18 85

WELL PURPOSE: *home*
(home, irrigation, municipal, industrial)

Coarse white sand

85 120

WELL COMPLETION DATA:

- (1) diameter (inches) *2"*
- (2) total depth (feet) *800'*
- (3) static water level (feet) *35'* below top of ground
- (4) casing *PVC*, *785'*
(material) (depth)

Soft Blue Clay

120 280

(size) if telescope see back.

- (5) screen *15'*, *785'*
(length) (depth to top)
- 2"*
(size) *PVC*
(material)

hard Blue Clay

280 315

- (6) pump *One*, *15*
(HP) (yield gpm)
- Electric*
(type power)

fine water sand

315 360

- (7) electric log *No*
(yes or no)

hard Blue Clay

360 540

(organization running log)

- (8) how well bottom plugged *2" hard water sand*

fine water sand

540 600

DRILLERS REMARKS: *19-B*

hard Blue Clay

600 740


DEPT. OF NATURAL RESOURCES
BUREAU OF LAND & WATER RESOURCES

OCT 31 1980

RECEIVED

If well telescopes please sketch and show depths.

GROUND LEVEL

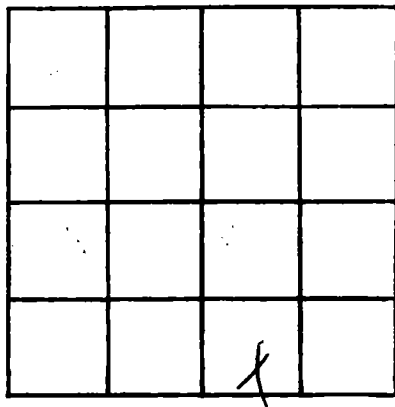

SECTION _____

Please indicate well location X.

ADDITIONAL INFORMATION

Multiple horizontal lines for entering additional information.

If more than one screen, show locations of each on sketch.