

MISSISSIPPI DEPARTMENT OF NATURAL RESOURCES

Bureau of Land and Water Resources

Southport Mall

P.O. Box 10631

Jackson, Mississippi 39209

COASTAL WATER WELL DRILLERS LOG

ROUTE 1 BOX 618

BILOXI, MISS

firm name 39537

county well located

JACKSON  
J 2085  
7-6-79

date well completed

7/6/79

*Johnson*

LANDOWNER:

*Walter Secoria*

*Cross West Rd*

*Clear Spring main*  
(mailing address)

WELL LOCATION:

sec *36-6* T. *6* N. R. *S. 1*

*1/4 mile NE Clear Spring*  
(distance) miles (direction) (nearest town)

WELL PURPOSE:

(home, irrigation, municipal, industrial) *home*

WELL COMPLETION DATA:

- (1) diameter (inches) *2"*
- (2) total depth (feet) *290'*
- (3) static water level (feet) *25'* below top of ground
- (4) casing *AK* *280'*  
(material) (depth)
- (5) screen *10'* *280'*  
(length) (depth to top)
- 2"*  
(size) *PVC*  
(material)
- (6) pump *One* *15*  
(HP) (yield gpm)
- Ele*  
(type power)
- (7) electric log *no*  
(yes or no)

(organization running log)

(8) how well bottom plugged

*2" backwash valve*  
DRILLERS REMARKS: *19-B*

description of formations encountered

from

to

<i>top soil</i>	<i>1</i>	<i>3</i>
<i>Black Clay</i>	<i>3</i>	<i>15</i>
<i>Super-Synth</i>	<i>15</i>	<i>20</i>
<i>5 ft Blue Clay</i>	<i>20</i>	<i>210</i>
<i>hard Blue Clay</i>	<i>210</i>	<i>260</i>
<i>fine water sand</i>	<i>260</i>	<i>270</i>
<i>good water sand</i>	<i>270</i>	<i>290</i>


DEPT. OF NATURAL RESOURCES  
BUREAU OF LAND & WATER RESOURCES

NOV - 3 1980

RECEIVED

If well telescopes please sketch and show depths.

GROUND LEVEL

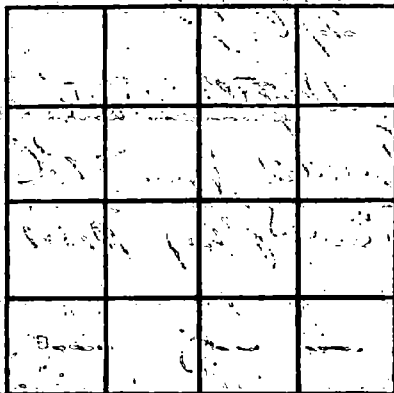

SECTION \_\_\_\_\_

Please indicate well location X.

ADDITIONAL INFORMATION

If more than one screen, show locations of each on sketch.