

Jackson
 J 20 86
 8-8-80

MISSISSIPPI
 BOARD OF WATER COMMISSIONERS
 416 North State Street
 Jackson, Mississippi 39201

WATER WELL DRILLERS LOG

8-8-80 date well completed
 Renew Well Drilling firm name
 Jackson county well located

LANDOWNER: Mrs. Deborah King
 Jeff Davis Apt. # 32
 Ocean Springs, Ms. 39564
 (mailing address)

description of formations encountered	from	to
Clay	0	40
sand	40	118
white clay	118	220
Blue clay	220	280
fine sand	280	405
Course Sand	405	420

WELL LOCATION:
 sec. 13 T. 6N R. 9E
 1 miles S.E. of Latimer
 (distance) (direction) (nearest town)

WELL PURPOSE:
 (home, irrigation, municipal, industrial)

WELL COMPLETION DATA:

(1) diameter (inches) 2"

(2) total depth (feet) 420 ft.

(3) static water level (feet) 60' below top of ground.

(4) casing pvc, 420' (material) (depth)

(5) screen 10' 410' (length) (depth to top)
 2" pvc (size) (material)

(6) pump 1 (HP) 12 (yield gpm)
 electric (type power)

(7) electric log (yes or no)

(8) how well bottom plugged Sand / Shale

DRILLERS REMARKS:


DEPT. OF NATURAL RESOURCES
 BUREAU OF LAND & WATER RESOURCES

OCT 3 1980

RECEIVED

If well telescopes please sketch and show depths.

GROUND LEVEL

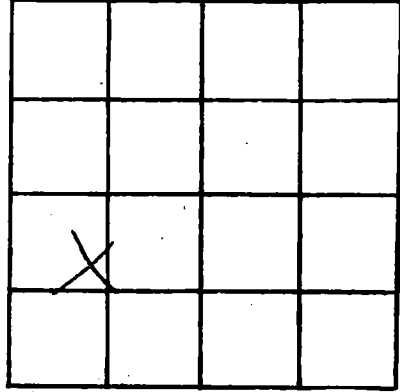

SECTION 13

Please indicate well location X.

ADDITIONAL INFORMATION

If more than one screen,
show locations of each on sketch.