

MISSISSIPPI DEPARTMENT OF NATURAL RESOURCES

Bureau of Land and Water Resources

Southport Mall

P.O. Box 10631

Jackson, Mississippi 39209

WATER WELL DRILLERS LOG

COASTAL DRILLING & SERVICE CO

Jackson
county well located

JACKSON
J 7088
12-2-79

12/17/79 19
date well completed

ROUTE 1 BOX 018
m from home

LANDOWNER: *Linda Wells*
Linda
Seamon Rd
OWNER'S (mailing address)

description of formations encountered	from	to
<i>top soil</i>	<i>1</i>	<i>3</i>
<i>Red Clay</i>	<i>3</i>	<i>18</i>
<i>gray sand</i>	<i>18</i>	<i>40</i>
<i>Calcare white sand</i>	<i>40</i>	<i>65</i>
<i>Soft blue clay</i>	<i>65</i>	<i>210</i>
<i>fine water sand</i>	<i>210</i>	<i>230</i>
<i>hard blue clay</i>	<i>230</i>	<i>330</i>
<i>fine water sand</i>	<i>330</i>	<i>360</i>
<i>fine water sand</i>	<i>360</i>	<i>396</i>

WELL LOCATION:
sec *22* T *6* N R *8* E
United Gas Line
(distance) (direction) (nearest town)

WELL PURPOSE: *home*
(home, irrigation, municipal, industrial)

WELL COMPLETION DATA:

- (1) diameter (inches) *2"*
- (2) total depth (feet) *396'*
- (3) static water level (feet) *65* below/above top of ground
- (4) casing *PVC* *386'*
(material) (depth)
- (size) If telescope see back.
- (5) screen *10'* *386'*
(length) (depth to top)
- 2"* *PVC*
(size) (material)
- (6) pump *one* *10*
(HP) (yield gpm)
- Ele*
(type power)
- (7) electric log *no*
(yes or no)

(organization running log)

(8) how well bottom plugged
2" back with valve

DRILLERS REMARKS: *19-13*


DEPT. OF NATURAL RESOURCES
BUREAU OF LAND & WATER RESOURCES

NOV - 5 1980

RECEIVED

If well telescopes please sketch and show depths.

GROUND LEVEL

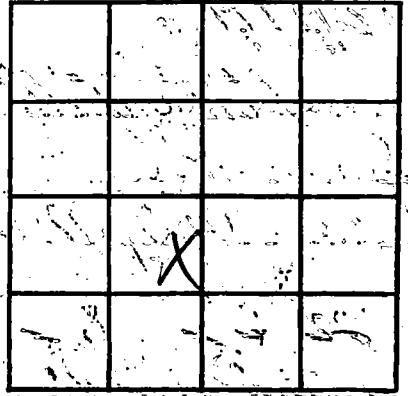

SECTION _____

Please indicate well location X.

ADDITIONAL INFORMATION

If more than one screen, show locations of each on sketch.