

MISSISSIPPI DEPARTMENT OF NATURAL RESOURCES

Bureau of Land and Water Resources

Southport Mall

P.O. Box 10631

Jackson, Mississippi 39209

WATER WELL DRILLERS LOG
COASTAL DRILLING & SERVICE CO.

ROUTE 1 BOX 618

firm name
BILOXI, MISS. 39532

county well located

JACKSON

J 2098

4-18-80

date well completed

LANDOWNER

description of formations encountered

from

to

Raymond Holman

top soil

1

3

Lakewood City

Red Clay

3

18

Ocean Springs Man
(mailing address)

Super Sand

18

35

WELL LOCATION:

sec. *11* T. *6* S. R. *9* E.

Soft Blue Clay

35

210

11 one miles *North* *Lakewood*
(distance) (direction) (nearest town)

Hard Blue Clay

210

245

WELL PURPOSE:

(home, irrigation, municipal, industrial)

fine water sand

245

265

WELL COMPLETION DATA:

- (1) diameter (inches) *2"*
- (2) total depth (feet) *285'*
- (3) static water level (feet) *40'* below top of ground.
- (4) casing *pk 225'*
(material) (depth)

good water sand

265

285

(size) If telescope see back.

- (5) screen *10'* *225'*
(length) (depth to top)

24 *psu*
(size) (material)

- (6) pump *one* *12*
(HP) (yield gpm)

ell
(type power)

- (7) electric log *no*
(yes or no)

(organization running log)

- (8) how well bottom plugged *2" bent wire chisel*

DRILLERS REMARKS:


DEPT. OF NATURAL RESOURCES
BUREAU OF LAND & WATER RESOURCES

NOV 12 1980

RECEIVED

If well telescopes please sketch and show depths.

GROUND LEVEL

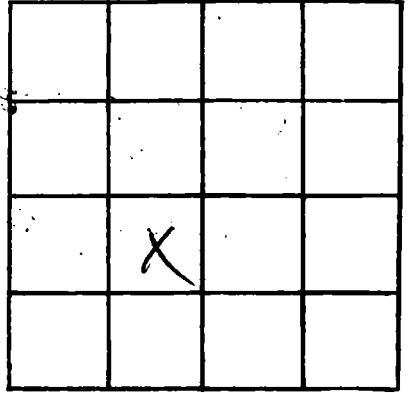

SECTION _____

Please indicate well location X.

ADDITIONAL INFORMATION

If more than one screen,
show locations of each on sketch.