

MISSISSIPPI DEPARTMENT OF NATURAL RESOURCES

Bureau of Land and Water Resources

Southport Mall

P.O. Box 10631

Jackson, Mississippi 39209

WATER WELL DRILLERS LOG  
COASTAL DRILLING & SERVICE CO.

JACKSON  
J 2095  
9-30-80  
9/30/80

date well completed 19

ROUTE 1 BOX 618

WELL name BILLOVI, MISS. 39532

Jackson county well located

LANDOWNER: Ed Jones

description of formations encountered

from to

Eds Jones City

<u>top soil</u>	1	3
<u>Red clay</u>	3	15
<u>white sand</u>	15	45
<u>Soft Blue clay</u>	45	180
<u>fine Blue clay</u>	180	200
<u>hard Blue clay</u>	200	380
<u>fine white sand</u>	380	400
<u>good white sand</u>	400	420

Billevi Min  
(mailing address)

WELL LOCATION:

sec. 26 T. 6 N. R. 9 E.  
2 1/2 miles S of Jatunice  
(distance) (direction) (nearest town)

WELL PURPOSE: private  
(home, irrigation, municipal, industrial)

WELL COMPLETION DATA:

- (1) diameter (inches) 2"
- (2) total depth (feet) 420'
- (3) static water level (feet) 40' below top of ground.
- (4) casing PVC 410'  
(material) (depth)
- (size) If telescope see back.
- (5) screen 10' 410'  
(length) (depth to top)
- 2" PVC  
(size) (material)
- (6) pump One 12  
(HP) (yield gpm)
- ELC  
(type power)
- (7) electric log no  
(yes or no)
- (organization running log)

(8) how well bottom plugged  
2" back with valve

DRILLERS REMARKS: 1916


DEPT. OF NATURAL RESOURCES  
BUREAU OF LAND & WATER RESOURCES

JAN 12 1981

RECEIVED

If well telescopes please sketch and show depths.

GROUND LEVEL

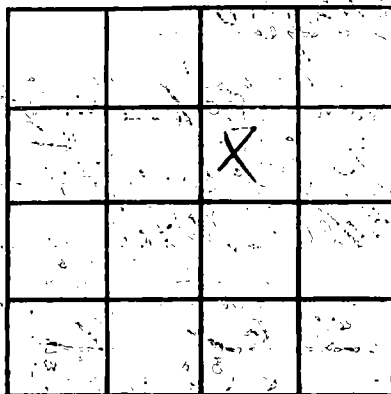

SECTION \_\_\_\_\_

Please indicate well location X.

ADDITIONAL INFORMATION

If more than one screen, show locations of each on sketch.