

MISSISSIPPI DEPARTMENT OF NATURAL RESOURCES

Bureau of Land and Water Resources

Southport Mall

P.O. Box 10631

Jackson, Mississippi 39209

WATER WELL DRILLERS LOG

Jackson  
J 2102  
4-13-81

4-13-81 19 date well completed  
Coast Water Well Sewer Inc. firm name  
Jackson county well located

LANDOWNER: Frank Yates  
P.O. Box 1046  
Gulfport, Miss  
(mailing address) 39501

WELL LOCATION:  
sec 26 T 6 N R 8 E  
5 miles SW of VANGLEAVE  
(distance) (direction) (nearest town)

WELL PURPOSE: None  
(home, irrigation, municipal, industrial)

WELL COMPLETION DATA:  
(1) diameter (inches) 2"  
(2) total depth (feet) 554'  
(3) static water level (feet) 69' below top of ground  
(4) casing PVC 544' (material) (depth)  
2" (size) if telescope see back.  
(5) screen 10' 544' (length) (depth to top)  
2" (size) PVC (material)  
(6) pump 1 hp 6 (HP) (yield gpm)  
Elec. (type power)  
(7) electric log No - (yes or no)  
(organization running log)

(8) how well bottom plugged  
back wash valve

description of formations encountered	from	to
Top soil	0	3'
Red Clay	3	24'
Red Coarse sand	24'	75'
Blue Clay	75'	215'
Blue Clay + Wood	215'	236'
Blue Clay	236'	279'
Blue Clay + streak of sand	279'	300'
Blue Clay	300'	340'
Gray Coarse sand	340'	385'
Blue Clay	385'	470'
Blue Clay + streak of sand	470'	490'
Gray Coarse sand	490'	554'

DEPT. OF NATURAL RESOURCES  
BUREAU OF LAND & WATER RESOURCES


JUN 2 - 1981

RECEIVED

DRILLERS REMARKS:

If well telescopes please sketch and show depths.

GROUND LEVEL

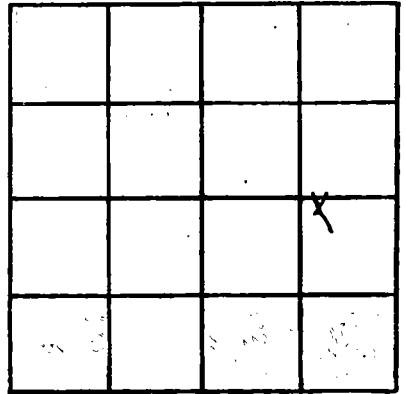

SECTION 26

Please indicate well location X.

ADDITIONAL INFORMATION

If more than one screen,  
show locations of each on sketch.