

MISSISSIPPI DEPARTMENT OF NATURAL RESOURCES

Bureau of Land and Water Resources

Southport Mall

P.O. Box 10631

Jackson, Mississippi 39209

WATER WELL DRILLERS LOG

JACKSON
J 2103
4-28-81
4-28-

81 Coaches Water Well Serv. Jackson
date well completed firm name county well located

LANDOWNER: Leon Andrews
P.O. Box 606
Pascagoula, Miss.
(mailing address) Home

Description of formations encountered	from	to
	Top soil	0
Red Clay	3'	30'
M. sand	30'	65'

WELL LOCATION:
sec. 3 T-6 R-8
5 miles W of VANCELEAVE
(distance) (direction) (nearest town)

WELL PURPOSE: None
(home, irrigation, municipal, industrial)

WELL COMPLETION DATA:

(1) diameter (inches) 2"

(2) total depth (feet) 65'

(3) static water level (feet) 25' below top of ground.

(4) casing PVC 60' (material) (depth)
2" (size) if telescope see back.

(5) screen 5' 60' (length) (depth to top)
1/2" PVC (size) (material)

(6) pump (HP) (yield gpm)
(type power)

(7) electric log No (yes or no)
(organization running log)

(8) how well bottom plugged
Back Wash Valve

DEPT. OF NATURAL RESOURCES
BUREAU OF LAND & WATER RESOURCES


JUN 2 - 1981

RECEIVED

DRILLERS REMARKS:

If well telescopes please sketch and show depths.

GROUND LEVEL

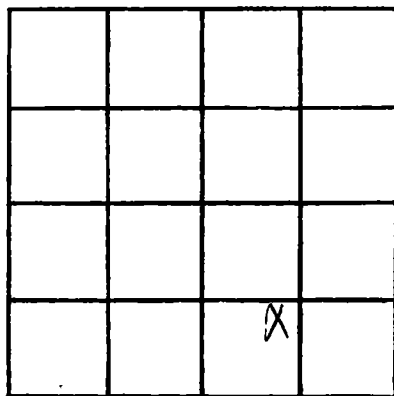

SECTION 3

Please indicate well location X.

ADDITIONAL INFORMATION

If more than one screen, show locations of each on sketch.