

MISSISSIPPI DEPARTMENT OF NATURAL RESOURCES

Bureau of Land and Water Resources

Southport Mall

P.O. Box 10631

Jackson, Mississippi 39209

WATER WELL DRILLERS LOG

JACKSON

JACKSON
J 2104
5-29-81

5-29-81

date well completed

19

Syman Well Co

firm name

~~Harrison~~

county well located

LANDOWNER:

Syana
9269 Comstock Ave,
Latimer

description of formations encountered

from

to

(mailing address)

yellow clay	0	6
yellow sand clay	6	35
clay	35	164
sand	164	180
clay	180	240
hard sand fin	240	258
clay	258	340
SAND fin	340	420

WELL LOCATION:

sec. 11 T-6 N. R-9 E W
0 miles 0 of Latimer
(distance) (direction) (nearest town)

WELL PURPOSE:

(home, irrigation, municipal, industrial)

WELL COMPLETION DATA:

- (1) diameter (inches) 2"
- (2) total depth (feet) 430'
- (3) static water level (feet) 22' below top of ground
- (4) casing PVC 420' (material) (depth)
2" (size) if telescope see back.
- (5) screen 10' 420' (length) (depth to top)
2" PVC (size) (material)
- (6) pump 1 (HP) 12 (yield gpm)
electric (type power)
- (7) electric log NO (yes or no)
NO (organization running log)
- (8) how well bottom plugged sand shark

DEPT. OF NATURAL RESOURCES
BUREAU OF LAND & WATER RESOURCES


OCT 20 1981

RECEIVED

DRILLERS REMARKS:

If well telescopes please sketch and show depths.

GROUND LEVEL

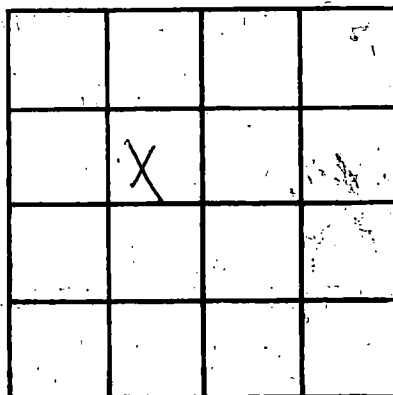

SECTION 11

Please indicate well location X.

ADDITIONAL INFORMATION

If more than one screen, show locations of each on sketch.