

MISSISSIPPI DEPARTMENT OF NATURAL RESOURCES

Bureau of Land and Water Resources

Southport Mall

P.O. Box 10631

Jackson, Mississippi 39209

WATER WELL DRILLERS LOG

Jackson
J 2105
5-18-81
5-18-

date well completed

firm name

county well located

81 Coast Water Well Sew. Jackson

LANDOWNER:

Helen M. Ben

description of formations encountered

from

to

9608 Highway 10
Ocean Springs, Miss.
(mailing address) 39164

Top soil
Red Clay
Red coarse sand

0 3'
31 25'
25' 65'

WELL LOCATION:

sec. 2 T 6 S R 8 E
5 miles W of PANOLA


WELL PURPOSE: Home
(home, irrigation, municipal, industrial)

WELL COMPLETION DATA:

- (1) diameter (inches) 2"
- (2) total depth (feet) 65'
- (3) static water level (feet) 27' below top of ground
- (4) casing PVC 55' (material) (depth)
- (5) screen 10' 55' (length) (depth to top)
- (6) pump 3" PVC 8 (size) (material) (yield gpm)
- (7) electric log No. (type power) (yes or no)
- (8) organization running log

how well bottom plugged
Back wash valve

DRILLERS REMARKS:

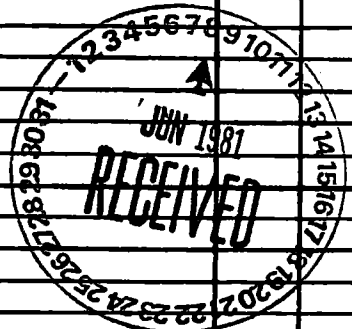

If well telescopes please sketch and show depths.

GROUND LEVEL

	X		

SECTION 2

Please indicate well location X.

ADDITIONAL INFORMATION

If more than one screen,
show locations of each on sketch.