

MISSISSIPPI DEPARTMENT OF NATURAL RESOURCES

Bureau of Land and Water Resources

Southport Mall

P.O. Box 10631

Jackson, Mississippi 39209

WATER WELL DRILLERS LOG

COASTAL DRILLING & SERVICE CO.

ROUTE 1 BOX 618

BILOXI, MISS. 39532

Jackson
J 2106
5-22-81

5/22/81
date well completed

Jackson
county well located

LANDOWNER: Lonny News

description of formations encountered

from to

Semon Rd

top soil

1 3

Ocean Spring Min
(mailing address)

clay

3 15

soft blue clay

15 190

fine white sand

190 205

soft white sand

205 220

WELL LOCATION:
sec. 19 T. 6 S. R. 9 W.

1/2 mile North with pipelines
(distance) (direction) (nearest town)

WELL PURPOSE: home
(home, irrigation, municipal, industrial)

WELL COMPLETION DATA:

(1) diameter (inches) 2"

(2) total depth (feet) 220'

(3) static water level (feet) 40' (below top of ground)

(4) casing PVC 210'
(material) (depth)

(size) If telescope see back.

(5) screen 10' 210'
(length) (depth to top)

2" PVC
(size) (material)

(6) pump one 12
(HP) (yield gpm)

Electric
(type power)

(7) electric log no
(yes or no)

(organization running log)

(8) how well bottom plugged
2" head work valve

DRILLERS REMARKS:


DEPT. OF NATURAL RESOURCES
BUREAU OF LAND & WATER RESOURCES

JUL 22 1981

RECEIVED

If well telescopes please sketch and show depths.

GROUND LEVEL

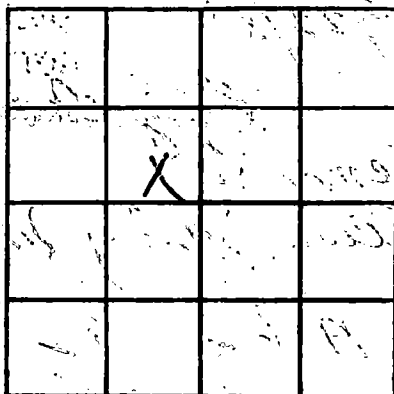

SECTION _____

Please indicate well location X.

ADDITIONAL INFORMATION

If more than one screen, show locations of each on sketch.