

MISSISSIPPI DEPARTMENT OF NATURAL RESOURCES

Bureau of Land and Water Resources

Southport Mall

P.O. Box 10631


Jackson, Mississippi 39209

WATER WELL DRILLERS LOG

Jackson  
J2108  
6-26-81

6-26-81 date well completed      Coastal Water Well Sew. Inc. firm name      Jackson county/well located

LANDOWNER:	description of formations encountered	from	to
<u>E.D. Heyman</u>	<u>Top soil</u>	<u>0</u>	<u>1'</u>
<u>7804 Jim Ramsey Rd.</u>	<u>Red Clay</u>	<u>1'</u>	<u>20'</u>
<u>Ocean Springs Miss.</u> (mailing address) <u>39564</u>	<u>Red coarse sand</u>	<u>20'</u>	<u>126'</u>
<u>sec. 12 T. 6 S. R. 8 E.</u>	<u>Red clay &amp; streak of sand</u>	<u>126'</u>	<u>162'</u>
<u>3 1/2</u> miles <u>W</u> of <u>VAN CLEAVE</u> (distance) (direction) (nearest town)	<u>Blue clay</u>	<u>162'</u>	<u>460'</u>
<u>WELL LOCATION:</u>	<u>Gray coarse sand</u>	<u>460'</u>	<u>515'</u>
<u>WELL PURPOSE:</u> <u>Home</u> (home, irrigation, municipal, industrial)			
<u>WELL COMPLETION DATA:</u>			
(1) diameter (inches) <u>2"</u>			
(2) total depth (feet) <u>515'</u>			
(3) static water level (feet) <u>93'</u> below top of ground. <u>above</u>			
(4) casing <u>PVC</u> , <u>505'</u> (material) (depth)			
<u>2"</u> (size) if telescope see back.			
(5) screen <u>10'</u> , <u>505'</u> (length) (depth to top)			
<u>2"</u> , <u>PVC</u> (size) (material)			
(6) pump <u>Shp.</u> , <u>7-7 1/2</u> (HP) (yield gpm)			
<u>Elect.</u> (type power)			
(7) electric log <u>No.</u> (yes or no)			
(organization running log)			
(8) How well bottom plugged <u>One Kwast tube</u>			

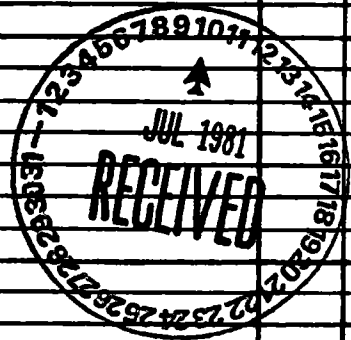

DRILLERS REMARKS:

If well telescopes please sketch and show depths.

GROUND LEVEL

	X		

SECTION 12

Please indicate well location X.

ADDITIONAL INFORMATION



If more than one screen, show locations of each on sketch.