

MISSISSIPPI DEPARTMENT OF NATURAL RESOURCES

Bureau of Land and Water Resources

Southport Mall

P.O. Box 10631

Jackson, Mississippi 39209

WATER WELL DRILLERS LOG

Jackson
J2169
6-26-81

6-26-81 81 Cross Water Well Sew. Jackson
date well completed firm name county well located


LANDOWNER: Ferguson
11709 Seaman Rd.
Ocean Springs, Miss.
(mailing address) 36554

description of formations encountered	from	to
Top soil	0	3'
R. Clay	3'	50'
M. Sand	50'	70'

WELL LOCATION:
sec. 22 T. 6 S. R. 8 E.
5 1/2 miles SW of VAN CLEAVE
(distance) (direction) (nearest town)

WELL PURPOSE: Home
(home, irrigation, municipal, industrial)

- WELL COMPLETION DATA:
- (1) diameter (inches) 2"
 - (2) total depth (feet) 70'
 - (3) static water level (feet) 35' below top of ground.
 - (4) casing PVC 65'
(material) (depth)
 - (5) screen 5' 65'
(length) (depth to top)
 - (6) pump 2" PVC
(size) (material)
 - (7) electric log No
(yes or no)
 - (8) How well bottom plugged?
Backhoe Valve

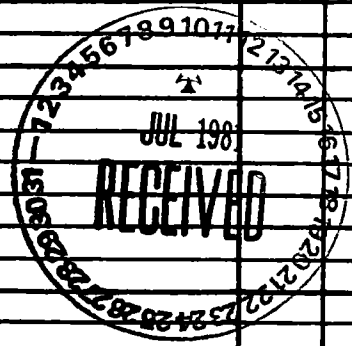

DRILLERS REMARKS:

