

MISSISSIPPI DEPARTMENT OF NATURAL RESOURCES

Bureau of Land and Water Resources

Southport Mall

P.O. Box 10631

Jackson, Mississippi 39209

WATER WELL DRILLERS LOG

JACKSON
J 2610
7-16-81

7-16 1981 Duncan Well Drilling Jackson
date well completed firm name county well located

LANDOWNER: Robert Morgan

description of formations encountered	from	to
<u>Sand & Clay mixed</u>	<u>0</u>	<u>75</u>
<u>fine sand</u>	<u>75</u>	<u>100</u>
<u>Coarse sand</u>	<u>100</u>	<u>130</u>

Ocean Springs, Ms.
(mailing address)

WELL LOCATION:

sec. 10 T. 6 N. R. 9 E. W
1 1/2 miles N. of Sutton
(distance) (direction) (nearest town)

WELL PURPOSE: Home
(home, irrigation, municipal, industrial)

WELL COMPLETION DATA:

- (1) diameter (inches) 2"
- (2) total depth (feet) 130'
- (3) static water level (feet) 35' below top of ground.
- (4) casing PVC, 110ft
(material) (depth)
 If telescope see back.
(size)
- (5) screen 10', 110'
(length) (depth to top)
2" PVC
(size) (material)
- (6) pump
(HP) (yield gpm)
electric
(type power)
- (7) electric log
(yes or no)

(organization running log)

(8) how well bottom plugged

DRILLERS REMARKS:


DEPT. OF NATURAL RESOURCES
BUREAU OF LAND & WATER RESOURCES
OCT 19 1981
RECORDED

If well telescopes please sketch and show depths.

GROUND LEVEL

100 100
120 100
0 100

Coarse sand
fine sand
Clay mixed

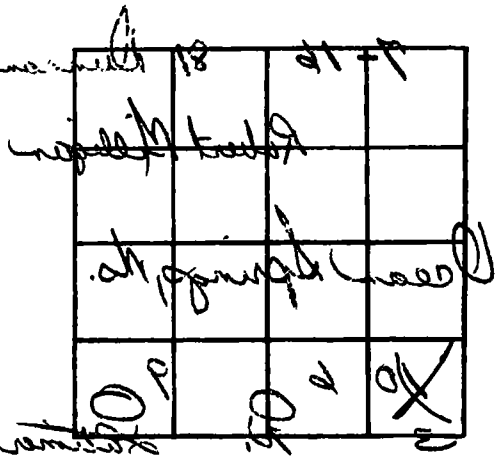

SECTION 10

Please indicate well location X.

ADDITIONAL INFORMATION

1587
 32
 10' 11"
 8' 11"
 8'
 7'

If more than one screen, show locations of each on sketch.