

MISSISSIPPI DEPARTMENT OF NATURAL RESOURCES

Bureau of Land and Water Resources

Southport Mall

P.O. Box 10631

Jackson, Mississippi 39209

WATER WELL DRILLERS LOG

JACKSON  
J 2111  
7-22-81

July 22 1981 Coastal Water Well Supply Jackson  
date well completed firm name county well located

LANDOWNER: Albert Reed

description of formations encountered from to

Box 6 - Box 332

Top soil 0 3'

Ocean Springs Miss.  
(mailing address) 39164

Red Clay 3' 25'

WELL LOCATION:

Red Coarse sand 25' 64'

sec. 11 T. 6 S. R. 8 W.  
4 miles W of VANCLANG  
(distance) (direction) (nearest town)

WELL PURPOSE: Home  
(home, irrigation, municipal, industrial)

WELL COMPLETION DATA:

(1) diameter (inches) 2"

(2) total depth (feet) 64'

(3) static water level (feet) 27' below top of ground.

(4) casing PVC 59'  
(material) (depth)  
2"  
(size) if telescope see back.

(5) screen 5' 59'  
(length) (depth to top)

2" PVC  
(size) (material)

(6) pump 1hp. 6 1/2  
(HP) (yield gpm)

Electric  
(type power)

(7) electric log No.  
(yes or no)

(organization running log)

(8) how well bottom plugged:  
Backwash valve

DEPT. OF NATURAL RESOURCES  
BUREAU OF LAND & WATER RESOURCES


AUG 14 1981

RECEIVED

DRILLERS REMARKS:

If well telescopes please sketch and show depths.

GROUND LEVEL

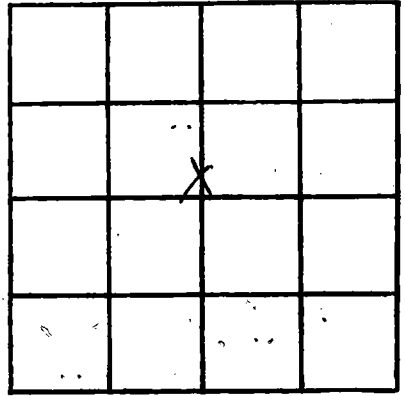

SECTION 11

Please indicate well location X.

ADDITIONAL INFORMATION

If more than one screen, show locations of each on sketch.