

MISSISSIPPI DEPARTMENT OF NATURAL RESOURCES

Bureau of Land and Water Resources

Southport Mall

P.O. Box 10631

Jackson, Mississippi 39209

WATER WELL DRILLERS LOG

JACKSON
J 2112
7-22-81

7-22-81 Cross Water Well Services Jackson
 date well completed firm name county well located

LANDOWNER: Magnum K. Burrey
Box 332
Ocean Springs, Miss
 (mailing address) 39164

description of formations encountered	from	to
<u>Top soil</u>	<u>0</u>	<u>3'</u>
<u>Red Clay</u>	<u>3'</u>	<u>25'</u>
<u>Red coarse sand</u>	<u>25'</u>	<u>64'</u>

WELL LOCATION:
 sec. 11 T. 6 S. R. 8 E.
4 miles W of VAN CLEAVE
 (distance) (direction) (nearest town)

WELL PURPOSE: Home
 (home, irrigation, municipal, industrial)

WELL COMPLETION DATA:

- (1) diameter (inches) 2"
- (2) total depth (feet) 64'
- (3) static water level (feet) 34' below top of ground.
- (4) casing PVC 59'
 (material) (depth)
2" if telescope see back.
 (size)
- (5) screen 5' 59'
 (length) (depth to top)
2" PVC
 (size) (material)
- (6) pump 1/2 6 1/2
 (HP) (yield gpm)
elect.
 (type power)
- (7) electric log No.
 (yes or no)
 (organization running log)

DEPT. OF NATURAL RESOURCES
 BUREAU OF LAND & WATER RESOURCES

AUG 14 1981


RECEIVED

(8) how well bottom plugged
back wash valve

DRILLERS REMARKS:

If well telescopes please sketch and show depths.

GROUND LEVEL

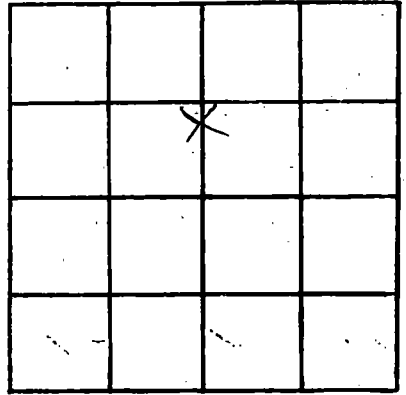

SECTION 1A

Please indicate well location X.

ADDITIONAL INFORMATION

If more than one screen, show locations of each on sketch.