

MISSISSIPPI DEPARTMENT OF NATURAL RESOURCES

Bureau of Land and Water Resources

Southport Mall

P.O. Box 10631

Jackson, Mississippi 39209

WATER WELL DRILLERS LOG

OK JACKSON
 J 2113
 7-29-81

July 29 1981 Coast Water Well Sew. Jackson
 date well completed firm name county well located

LANDOWNER: *Jack Dippert*
 10717 Cherokee Rose Rd.
 Ocean Springs, Miss.
 (mailing address) 39564

WELL LOCATION:
 sec. *24* T. *6* S. R. *8* W.
 4 miles SW of VANCELAUE
 (distance) (direction) (nearest town)

WELL PURPOSE: *HOME*
 (home, irrigation, municipal, industrial)

- WELL COMPLETION DATA:
- (1) diameter (inches) *9"*
 - (2) total depth (feet) *547'*
 - (3) static water level (feet) *63'* below top of ground
 - (4) casing *PVC* *537'*
 (material) (depth)
 - 2"* if telescope see back.
 (size)
 - (5) screen *10'* *537'*
 (length) (depth to top)
 - 2"* *PVC*
 (size) (material)
 - (6) pump *HP.* *6 1/2*
 (HP) (yield gpm)
 - Elect.*
 (type power)
 - (7) electric log *No-*
 (yes or no)
 - (organization running log)

description of formations encountered	from	to
<i>Red Clay</i>	<i>5'</i>	<i>39'</i>
<i>Blue Clay</i>	<i>39'</i>	<i>90'</i>
<i>White Med. Sand</i>	<i>90'</i>	<i>110'</i>
<i>Blue Clay</i>	<i>110'</i>	<i>169'</i>
<i>Gray Coarse sand</i>	<i>169'</i>	<i>196'</i>
<i>Blue Clay</i>	<i>196'</i>	<i>230'</i>
<i>Blue Clay & Sheet of Sand</i>	<i>230'</i>	<i>300'</i>
<i>Blue Clay</i>	<i>300'</i>	<i>322'</i>
<i>Gray Coarse sand</i>	<i>322'</i>	<i>380'</i>
<i>Blue Clay</i>	<i>380'</i>	<i>426'</i>
<i>Blue Clay & Sheet of Sand</i>	<i>426'</i>	<i>438'</i>
<i>Blue Clay</i>	<i>438'</i>	<i>479'</i>
<i>Gray fine sand</i>	<i>479'</i>	<i>512'</i>
<i>Gray Med. Sand</i>	<i>512'</i>	<i>547'</i>

DEPT. OF NATURAL RESOURCES
 BUREAU OF LAND & WATER RESOURCES

AUG 14 1981


RECEIVED

(8) how well bottom plugged
Back wash valve

DRILLERS REMARKS:

If well telescopes please sketch and show depths.

GROUND LEVEL

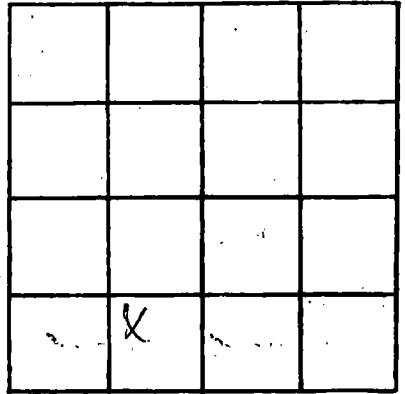

SECTION 24

Please indicate well location X.

ADDITIONAL INFORMATION

If more than one screen, show locations of each on sketch.