

MISSISSIPPI DEPARTMENT OF NATURAL RESOURCES

Bureau of Land and Water Resources

Southport Mall

P.O. Box 10631

Jackson, Mississippi 39209

COASTAL WATER WELL DRILLERS LOG

ROUTE 1 BOX 618

BILOXI, MISS firm name 39532

JACKSON
J 2114
8-11-81

01/11/81 19
date well completed

Jackson
county well located

LANDOWNER: David Bentley

description of formations encountered

from to

lt 5

Clear Spring Drive
(mailing address)

top soil	1	3
Red Clay	3	15
White Sand	15	100
Soft Blue Clay	100	210
Hard Blue Clay	210	265
Grey Water Sand	265	290
Dark Water Sand	290	310

WELL LOCATION:

sec 14 T 6 N R 9 S W
Satsuma of
(distance) miles (direction) of (nearest town)

WELL PURPOSE: home
(home, irrigation, municipal, industrial)


WELL COMPLETION DATA:

- (1) diameter (inches) 2"
- (2) total depth (feet) 310'
- (3) static water level (feet) 40' below above top of ground.
- (4) casing PVC 300'
(material) (depth)
- (size) if telescope see back.
- (5) screen 10' 300'
(length) (depth to top)
- 2" PVC
(size) (material)
- (6) pump One 1/2 12
(HP) (yield gpm)
- 3/4
(type power)
- (7) electric log no
(yes or no)

(organization running log)


(8) how well bottom plugged
2' deep sand below

DRILLERS REMARKS: 19-18

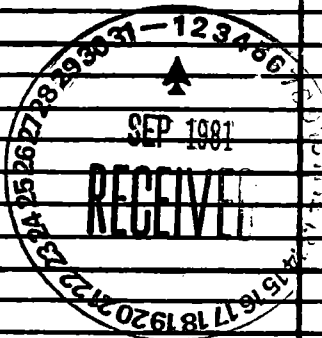

If well telescopes please sketch and show depths.

GROUND LEVEL

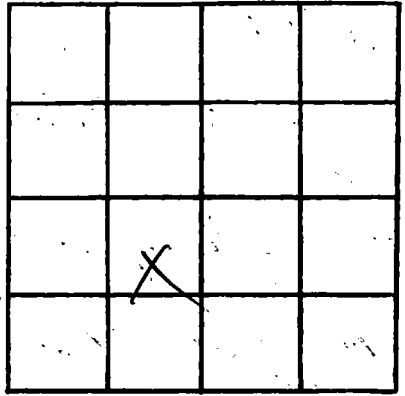

SECTION _____

Please indicate well location X.

ADDITIONAL INFORMATION

If more than one screen, show locations of each on sketch.