

MISSISSIPPI DEPARTMENT OF NATURAL RESOURCES

Bureau of Land and Water Resources

Southport Mall

P.O. Box 10631

Jackson, Mississippi 39209

WATER WELL DRILLERS LOG

JACKSON
J 211S
8-26-81

Aug 26 - 1981 Coast Water Well Sew. Inc. Jackson
date well completed firm name county well located


LANDOWNER: Tom Lewis
12412 Lemon Rd.
Ocean Springs, Miss.
(mailing address) 39564

WELL LOCATION:
sec. 4 T. 6 S. R. 8 E.
4 miles WSW of Zachary
(distance) (direction) (nearest town)

WELL PURPOSE: Home
(home, irrigation, municipal, industrial)

WELL COMPLETION DATA:
(1) diameter (inches) 2"
(2) total depth (feet) 430'
(3) static water level (feet) 60' below top of ground.
(4) casing PVC, 420'
(size) (material) (depth)
2" if telescope see back.
(5) screen 10', 420'
(length) (depth to top)
2" PVC
(size) (material)
(6) pump 1 hp., 7 1/2
(HP) (yield gpm)
Electric
(type power)
(7) electric log No.
(yes or no)
(organization running log)
(8) how well bottom plugged
back wash valve


description of formations encountered	from	to
Top soil	0	2'
R. Clay	2'	25'
O. Sand	25'	70'
B. Clay	70'	105'
C. Sand	105'	180'
B. Clay	180'	186'
M. Sand	186'	221'
B. Clay	221'	386'
M. Sand	386'	430'

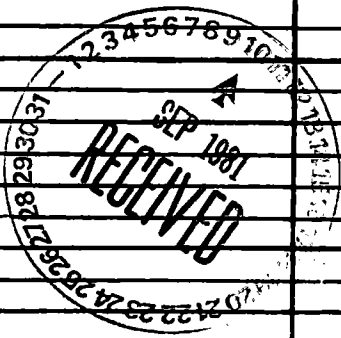

DRILLERS REMARKS:

If well telescopes please sketch and show depths.

GROUND LEVEL

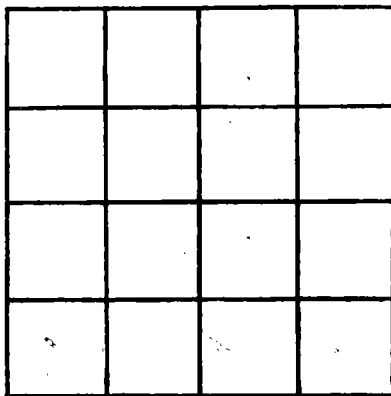

SECTION _____

Please indicate well location X.

ADDITIONAL INFORMATION

If more than one screen, show locations of each on sketch.