

MISSISSIPPI DEPARTMENT OF NATURAL RESOURCES

Bureau of Land and Water Resources

Southport Mall

P.O. Box 10631

Jackson, Mississippi 39209

WATER WELL DRILLERS LOG

JACKSON  
J 2117  
9-8-81

Sept. 8 1981 *Duncan Well Drilling Jackson*  
date well completed firm name county well located


LANDOWNER: <i>Jillane Landritt</i> <i>9649 New St.</i>	Description of formations encountered	from	to
<i>D.S. No. 39564</i> (mailing address)	<i>Clay sand</i>	<i>0</i>	<i>15</i> <i>15</i> <i>25</i>
<b>WELL LOCATION:</b>			
sec. <i>26</i> T. <i>6</i> N R. <i>9</i> E <i>5</i> miles <i>SW</i> of <i>Latimer</i> (distance) (direction) (nearest town)			
<b>WELL PURPOSE:</b> <i>Home</i> (home, irrigation, municipal, industrial)			
<b>WELL COMPLETION DATA:</b>			
(1) diameter (inches) <i>2"</i>			
(2) total depth (feet) <i>85 ft.</i>			
(3) static water level (feet) <i>20'</i> <i>below</i> top of ground.			
(4) casing <i>PVC</i> , <i>75'</i> (material) (depth)			
_____ (size) if telescope see back.			
(5) screen <i>10'</i> , <i>75'</i> (length) (depth to top)			
<i>2"</i> , <i>PVC</i> (size) (material)			
(6) pump <i>1</i> , <i>8</i> (HP) (yield gpm)			
<i>electric</i> (type power)			
(7) electric log _____ (yes or no)			
_____ (organization running log)			
(8) how well bottom plugged <i>Sand</i> <i>shank</i>			
DRILLERS REMARKS: _____			

DEPT. OF NATURAL RESOURCES  
BUREAU OF LAND & WATER RESOURCES

OCT 19 1981  
RECEIVED

If well telescopes please sketch and show depths.

GROUND LEVEL

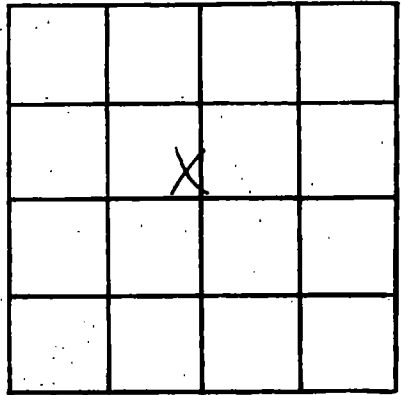

SECTION 26

Please indicate well location X.

ADDITIONAL INFORMATION

If more than one screen,  
show locations of each on sketch.