

MISSISSIPPI DEPARTMENT OF NATURAL RESOURCES

Bureau of Land and Water Resources

Southport Mall

P.O. Box 10631

Jackson, Mississippi 39209

WATER WELL DRILLERS LOG

Jackson
 52119
 9-25-81

Sept. 25 1981 date well completed
 Duncan Well Drilling firm name
 Jackson county well located

LANDOWNER: Marc Snoddy
 6515 N. Washington
 Ocean Springs, Ms.
 (mailing address)

description of formations encountered	from	to
Clay & Sand mixed	0	85
Blue Clay	85	115
Blue Clay	115	180
fine sand	180	200
Coarse Sand	200	220

WELL LOCATION:
 sec. 10 T 6 N R 9 E
 3 1/2 miles N of (Patmon)

WELL PURPOSE: Home
 (home, irrigation, municipal, industrial)


- WELL COMPLETION DATA:
- (1) diameter (Inches) 4"
 - (2) total depth (feet) 220'
 - (3) static water level (feet) 20' below top of ground
 - (4) casing PVC, 210' (material) (depth)
 - (5) screen 10' 210' (length) (depth to top)
 2" PVC (size) (material)
 - (6) pump 1 1/2 HP 15 (yield gpm)
 electric (type power)
 - (7) electric log (yes or no)
 - (8) how well bottom plugged Sand

DRILLERS REMARKS:

DEPT. OF NATURAL RESOURCES
 BUREAU OF LAND & WATER RESOURCES
 OCT 10 1981
 RECEIVED

If well telescopes please sketch and show depths.

GROUND LEVEL

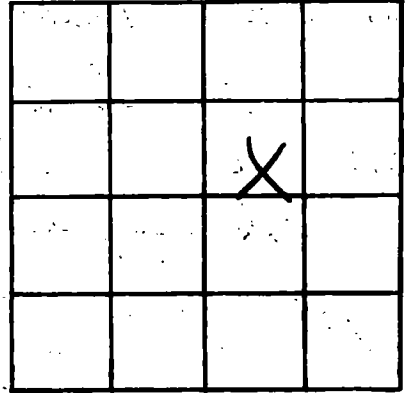

SECTION 10

Please indicate well location X.

ADDITIONAL INFORMATION

If more than one screen, show locations of each on sketch.