

MISSISSIPPI DEPARTMENT OF NATURAL RESOURCES
Bureau of Land and Water Resources
 Southport Mall
 P.O. Box 10631
 Jackson, Mississippi 39209
WATER WELL DRILLERS LOG

Jackson
 J 2120
 9-28-81

9-28-81 date well completed 81 Coast Water Well Sew. Co. firm name Jackson county well located

LANDOWNER: *Jackie Massey*
P.O. Box 241V
Ocean Springs, Miss.
 (mailing address) *35564*

description of formations encountered	from	to
<i>Top soil</i>	<i>0'</i>	<i>7'</i>
<i>Blue Clay</i>	<i>7'</i>	<i>26'</i>
<i>White coarse sand - gravel & pore</i>	<i>26'</i>	<i>44'</i>
<i>Blue Clay & streak of sand</i>	<i>44'</i>	<i>75'</i>
<i>Blue Clay</i>	<i>75'</i>	<i>207'</i>
<i>Blue Clay & streak of sand</i>	<i>207'</i>	<i>226'</i>
<i>Blue Clay</i>	<i>226'</i>	<i>307'</i>
<i>Blue Clay & streak of sand</i>	<i>307'</i>	<i>319'</i>
<i>Blue Clay</i>	<i>319'</i>	<i>345'</i>
<i>Blue Clay & streak of sand</i>	<i>345'</i>	<i>365'</i>
<i>gray fine sand</i>	<i>365'</i>	<i>380'</i>
<i>gray coarse sand</i>	<i>380'</i>	<i>416'</i>

WELL LOCATION:
 sec. *35* T. *6* N. R. *9* E.
5 miles (distance) *NW* (direction) of *Ocean Springs* (nearest town)

WELL PURPOSE: *Home*
 (home, irrigation, municipal, industrial)

WELL COMPLETION DATA:

(1) diameter (inches) *2"*

(2) total depth (feet) *416'*

(3) static water level (feet) *77'* below above top of ground.

(4) casing *PVC* (material) *406'* (depth)
2" (size) if telescope see back.

(5) screen *10'* (length) *406'* (depth to top)
2" (size) *PVC* (material)

(6) pump *slp.* (HP) *8* (yield gpm)
Elect. (type power)

(7) electric log *No.* (yes or no)
 (organization running log)

DEPT. OF NATURAL RESOURCES
 BUREAU OF LAND & WATER RESOURCES

OCT 10 1981


RECEIVED

(8) How well bottom plugged
backwash valve

DRILLERS REMARKS:

If well telescopes please sketch and show depths.

GROUND LEVEL

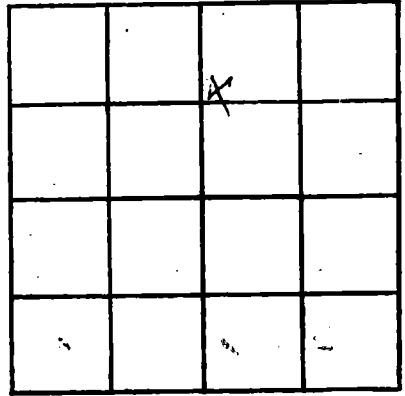

SECTION _____

Please indicate well location X.

ADDITIONAL INFORMATION

If more than one screen,
show locations of each on sketch.