

MISSISSIPPI DEPARTMENT OF NATURAL RESOURCES

Bureau of Land and Water Resources

Southport Mall

P.O. Box 10631

Jackson, Mississippi 39209

COASTAL DRILLING & SERVICE CO. WATER WELL DRILLERS LOG

ROUTE 1 BOX 618

BILOXI, MISS. 39532 firm name

Jackson county well located

Jackson
J 2123

10/23/71
date well completed

LANDOWNER: W.T. Brown
Jim Ramsey Rd
Olean Springs, Miss
(mailing address)

description of formations encountered	from	to
<u>Topsoil</u>	<u>1</u>	<u>3</u>
<u>Red Clay</u>	<u>3</u>	<u>15</u>
<u>White Sand</u>	<u>15</u>	<u>40</u>
<u>5 ft Blue Clay</u>	<u>40</u>	<u>210</u>
<u>fine water sand</u>	<u>210</u>	<u>245</u>
<u>Hard Blue Clay</u>	<u>245</u>	<u>480</u>
<u>fine water sand</u>	<u>480</u>	<u>525</u>
<u>good water sand</u>	<u>525</u>	<u>530</u>

WELL LOCATION:
sec. 4 T. 6 S. R. 8 E
1/2 South povertine
(distance) (direction) (nearest town)

WELL PURPOSE: Water
(home, irrigation, municipal, industrial)

WELL COMPLETION DATA:

(1) diameter (inches) 2"

(2) total depth (feet) 530'

(3) static water level (feet) 60' below top of ground

(4) casing PVC 520'
(material) (depth)
(size) if telescope see back.

(5) screen 10' 520'
(length) (depth to top)
2" PVC
(size) (material)

(6) pump 1/2 10 gpm
(HP) (yield gpm)
3/4
(type power)

(7) electric log no
(yes or no)
(organization running log)

(8) how well bottom plugged:
2' back with valve
Sealed
DRILLERS REMARKS:


DEPT. OF NATURAL RESOURCES
BUREAU OF LAND & WATER RESOURCES

JAN 21 1982

RECEIVED

If well telescopes please sketch and show depths.

GROUND LEVEL

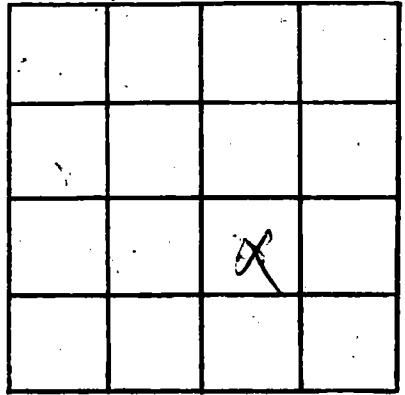

SECTION 4

Please indicate well location X.

ADDITIONAL INFORMATION

If more than one screen, show locations of each on sketch.