

MISSISSIPPI DEPARTMENT OF NATURAL RESOURCES

Bureau of Land and Water Resources

Southport Mall

P.O. Box 10631

Jackson, Mississippi 39209

WATER WELL DRILLERS LOG

Jackson
J. 2125

Dec. 12

1981

Duncan Well Drilling

firm name

Jackson

county well located

LANDOWNER: Lee Ables

Rt. 1 Box 458 B

Biloxi, Mo. 39532

(mailing address)

description of formations encountered

from

to

Top Sand & Mud

0 90

Blue Clay

90 200

fine sand

200 250

Blue Clay

250 316

Blue silt Clay

316 420

Sand

420 448

WELL LOCATION:

sec. 34 T 6 N R 9 E
3 miles S of Abner

WELL PURPOSE: Home
(home, irrigation, municipal, industrial)

WELL COMPLETION DATA:

- (1) diameter (inches) 2"
- (2) total depth (feet) 448
- (3) static water level (feet) 32' below above top of ground.
- (4) casing PVC, 438' (material) (depth)
(size) If telescope see back.
- (5) screen 10' 438' (length) (depth to top)
2" PVC (size) (material)
- (6) pump 1 (HP) 10 (yield gpm)
electric (type power)
- (7) electric log (yes or no)

(organization running log)

(8) how well bottom dug Sand
Shack

DRILLERS REMARKS:


DEPT. OF NATURAL RESOURCES
BUREAU OF LAND & WATER RESOURCES

FEB 11 1982

RECEIVE

If well telescopes please sketch and show depths.

GROUND LEVEL

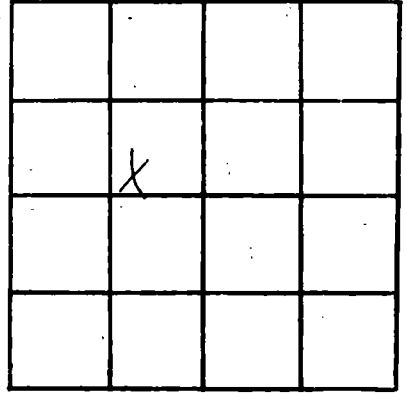

SECTION 34

Please indicate well location X.

ADDITIONAL INFORMATION

If more than one screen, show locations of each on sketch.