

MISSISSIPPI DEPARTMENT OF NATURAL RESOURCES

Bureau of Land and Water Resources

Southport Mall

P.O. Box 10631

Jackson, Mississippi 39209

Jackson
82126

WATER WELL DRILLERS LOG
COASTAL DRILLING & SERVICE CO.

1/27/82
date well completed

ROUTE 1 BOX 618

firm name

Jackson
county well located

BILOXI, MISS. 39532

LANDOWNER: Mr. Brown
Off Seaman Road
Ocean Springs Man
(mailing address)

description of formations encountered	from	to
top soil	1	3
Red Clay	3	15
gray sand	15	40
Coarse white sand	40	90
light blue clay	90	210
hard blue clay	210	415
fine white sand	415	430

WELL LOCATION:

sec 30-T 6 R 8
2 1/2 mi NE Inlet A
(distance) (direction) (nearest town)

WELL PURPOSE: home
(home, irrigation, municipal, industrial)

WELL COMPLETION DATA:

- (1) diameter (inches) 2"
- (2) total depth (feet) 430'
- (3) static water level (feet) 55' below top of ground.
- (4) casing pvc 420'
(material) (depth)
- (size) If telescope see back.
- (5) screen 10' 420'
(length) (depth to top)
- 2" pvc
(size) (material)
- (6) pump 10hp 10
(HP) (yield gpm)
- Elle
(type power)
- (7) electric log no
(yes or no)

(organization running log)

(8) how well bottom plugged
Seal
DRILLERS REMARKS


DEPT. OF NATURAL RESOURCES
BUREAU OF LAND & WATER RESOURCES

MAR - 2 1982

RECEIVED

If well telescopes please sketch and show depths.

GROUND LEVEL

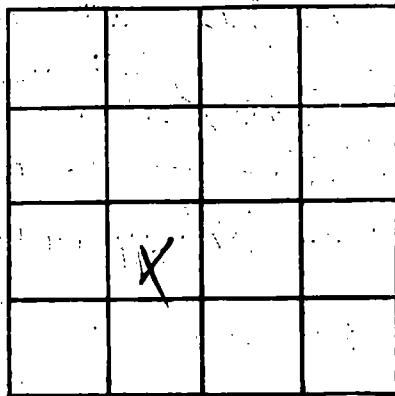

SECTION _____

Please indicate well location X.

ADDITIONAL INFORMATION

If more than one screen, show locations of each on sketch.