

MISSISSIPPI DEPARTMENT OF NATURAL RESOURCES
Bureau of Land and Water Resources
 Southport Mall
 P.O. Box 10631
 Jackson, Mississippi 39209
WATER WELL DRILLERS LOG

Jackson
J2127

Feb. 4 1982 Duncan Well Drilling Jackson
 date well completed firm name county well located

LANDOWNER: Clery Champagne
Rt. 1 Box 340
Ocean Springs, Miss.
 (mailing address)

description of formations encountered	from	to
<u>Top Soil</u>	<u>0</u>	<u>10</u>
<u>Sand</u>	<u>10</u>	<u>35</u>

WELL LOCATION:
 sec. 10 T. 6 N. R. 9 E.
3 miles N of Lattimer
 (distance) (direction) (nearest town)

WELL PURPOSE:
 (home, irrigation, municipal, industrial)

- WELL COMPLETION DATA:
- (1) diameter (inches) 2"
 - (2) total depth (feet) 35 ft
 - (3) static water level (feet) 2' ^{below} _{above} top of ground.
 - (4) casing PVC, 25
 (material) (depth)
 (size) if telescope see back.
 - (5) screen 10', 25
 (length) (depth to top)
2", PVC
 (size) (material)
 - (6) pump 1/2, 8
 (HP) (yield gpm)
electric
 (type power)
 - (7) electric log
 (yes or no)
 (organization running log)
 - (8) how well bottom plugged sand
Mark

DRILLERS REMARKS:


DEPT. OF NATURAL RESOURCES
 BUREAU OF LAND & WATER RESOURCES

FEB 11 1982

RECEIVED

If well telescopes please sketch and show depths.

GROUND LEVEL

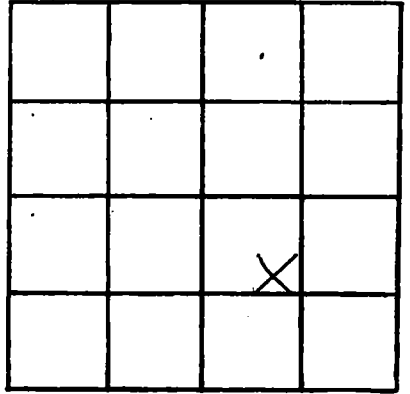

SECTION 10

Please indicate well location X.

ADDITIONAL INFORMATION

If more than one screen,
show locations of each on sketch.