

MISSISSIPPI DEPARTMENT OF NATURAL RESOURCES

Bureau of Land and Water Resources

Southport Mall

P.O. Box 10631

Jackson, Mississippi 39209

COASTAL DRILLING & SERVICE CO.
WATER WELL DRILLERS LOG

ROUTE 1 BOX 618

BILOXI, MISS. 39532

4/6/72
date well completed

Jackson
county well located

LANDOWNER: Ray Thomas

description of formations encountered

from to

144 Tucker Road

Ocean Springs Ms
(mailing address)

top soil	1	3
red clay	3	35
white sand	35	60
soft blue clay	60	210
shaggy sand	210	240
hard blue clay	240	390
fine water sand	390	420
good water sand	420	440

WELL LOCATION:

sec 36-T-6 R 9-E
Inset A of
(distance) (direction) of (nearest town)

WELL PURPOSE: home
(home, irrigation, municipal, industrial)

WELL COMPLETION DATA:

- (1) diameter (inches) 4 1/2"
- (2) total depth (feet) 440'
- (3) static water level (feet) 60 below top of ground.
- (4) casing 4 1/2" (material) PCU (depth) 425'
4 1/2" (size) if telescope see back.
- (5) screen 15' (length) 425' (depth to top)
2" (size) PCU (material)
- (6) pump 1/2 (HP) 18 (yield gpm)
ch (type power)
- (7) electric log no (yes or no)

(organization running log)

(8) how well bottom plugged
2nd bottom plugged

DRILLERS REMARKS: 196

DEPT. OF NATURAL RESOURCES
BUREAU OF LAND & WATER RESOURCES

OCT 14 1982

RECEIVED

If well telescopes please sketch and show depths.

GROUND LEVEL


1160' 4" P.C. Casing

265' 2" P.C. Casing

15' 2" P.C. Screen

2" Lead Wire Valve
19-18

If more than one screen, show locations of each on sketch.

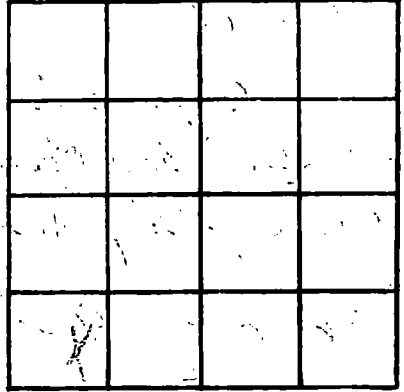

SECTION _____

Please indicate well location X.

ADDITIONAL INFORMATION

Lined area for additional information.