

MISSISSIPPI DEPARTMENT OF NATURAL RESOURCES

Bureau of Land and Water Resources

Southport Mall

P.O. Box 10631

Jackson, Mississippi 39209

WATER WELL DRILLERS LOG

Jackson  
52132

April 5 1982 *Duncan Well Drilling Jackson*  
date well completed firm name county well located

LANDOWNER: *Joe Beding*  
*713 Lipp Road*  
*Ocean Springs, Ms.*  
(mailing address)

description of formations encountered

from

to

<i>sand + clay</i>	<i>0</i>	<i>100</i>
<i>Blue clay</i>	<i>100</i>	<i>180</i>
<i>fine sand</i>	<i>180</i>	<i>210</i>
<i>Blue clay</i>	<i>210</i>	<i>360</i>
<i>course sand</i>	<i>360</i>	<i>380</i>

WELL LOCATION:

sec. 10 T. 6 N. R. 9 E.  
3 miles N of Stines  
(distance) (direction) (nearest town)

WELL PURPOSE: *Home*  
(home, irrigation, municipal, industrial)

WELL COMPLETION DATA:

- (1) diameter (inches) 2"
- (2) total depth (feet) 380'
- (3) static water level (feet) 20' <sup>below</sup>/<sub>above</sub> top of ground.
- (4) casing PVC 370'  
(material) (depth)
- (size) if telescope see back.
- (5) screen 10' 370'  
(length) (depth to top)
- 2" PVC  
(size) (material)
- (6) pump \_\_\_\_\_ (HP) \_\_\_\_\_ (yield gpm)  
electric  
(type power)
- (7) electric log \_\_\_\_\_ (yes or no)

(organization running log)

(8) how well bottom plugged Sand  
shark

DRILLERS REMARKS: *Owner had his own pump*


DEPT. OF NATURAL RESOURCES  
BUREAU OF LAND & WATER RESOURCES

AUG 30 1982

RECEIVED

If well telescopes please sketch and show depths.

GROUND LEVEL

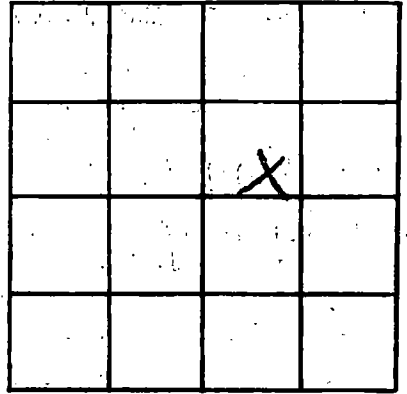

SECTION 10

Please indicate well location X.

ADDITIONAL INFORMATION

If more than one screen,  
show locations of each on sketch.