

MISSISSIPPI DEPARTMENT OF NATURAL RESOURCES

Bureau of Land and Water Resources

Southport Mall

P.O. Box 10631

Jackson, Mississippi 39209

WATER WELL DRILLERS LOG

Jackson  
J 2133

July 2 1982 82 Duncan Well Drilling Jackson  
 date well completed firm name county well located

LANDOWNER: Sheppard Gosselin  
Rt. 5 Box 298  
Ocean Springs, Ms.  
 (mailing address)

Description of formations encountered	from	to
Sand & Mud	0	25
White clay	25	80
Blue Clay	80	250
Sand & Clay	250	300
Blue Clay	300	360
Course sand	360	400

WELL LOCATION:  
 sec 18 T 6 N R 8 E  
10 miles NW of Ocean Springs  
 (distance) (direction) (nearest town)

WELL PURPOSE: Home  
 (home, irrigation, municipal, industrial)

WELL COMPLETION DATA:

(1) diameter (Inches) 2"

(2) total depth (feet) 400 ft.

(3) static water level (feet) 20' below above top of ground.

(4) casing pvc 390'  
 (material) (depth)

(size) If telescope see back.

(5) screen 10' 390'  
 (length) (depth to top)

2" pvc  
 (size) (material)

(6) pump 1 10  
 (HP) (yield gpm)

electric  
 (type power)

(7) electric log \_\_\_\_\_  
 (yes or no)

\_\_\_\_\_  
 (organization running log)

DEPT. OF NATURAL RESOURCES  
 BUREAU OF LAND & WATER RESOURCES

AUG 30 1982


RECEIVED

(8) how well bottom plugged Sand  
Mark

DRILLERS REMARKS:

If well telescopes please sketch and show depths.

GROUND LEVEL

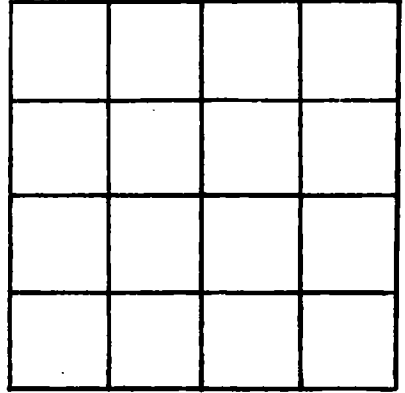

SECTION \_\_\_\_\_

Please indicate well location X.

ADDITIONAL INFORMATION

If more than one screen, show locations of each on sketch.