

MISSISSIPPI DEPARTMENT OF NATURAL RESOURCES

Bureau of Land and Water Resources

Southport Mall

P.O. Box 10631

Jackson, Mississippi 39209

WATER WELL DRILLERS LOG

Jackson
 52134

7-21-82 19 *Coast Water Well Saw.* *Jackson*
 date well completed firm name county well located

LANDOWNER: *Tom Coleman*
219 Audrey Chick
Ocean Springs, Miss.
 (mailing address) *39564*

description of formations encountered	from	to
<i>Top soil</i>	<i>0</i>	<i>3'</i>
<i>R. Clay</i>	<i>3'</i>	<i>17'</i>
<i>C Sand</i>	<i>17'</i>	<i>60'</i>

WELL LOCATION:
 sec. *22* T. *6* N. R. *8* E
5 miles *WSW* of *Winleaze*
 (distance) (direction) (nearest town)

WELL PURPOSE: *Home*
 (home, irrigation, municipal, industrial)

WELL COMPLETION DATA:
 (1) diameter (inches) *2"*
 (2) total depth (feet) *60'*
 (3) static water level (feet) *15* below above top of ground.
 (4) casing *PVC*, *50'*
 (material) (depth)
2" if telescope see back.
 (size)
 (5) screen *10*, *50'*
 (length) (depth to top)
2" *PVC*
 (size) (material)
 (6) pump *1/2 hp.* - *8*
 (HP) (yield gpm)
elec.
 (type power)
 (7) electric log *no.*
 (yes or no)
 (organization running log)

(8) How well bottom plugged
Back wash valve

DRILLERS REMARKS:


DEPT. OF NATURAL RESOURCES
 BUREAU OF LAND & WATER RESOURCES

SEP - 1 1982

RECEIVED

If well telescopes please sketch and show depths.

GROUND LEVEL

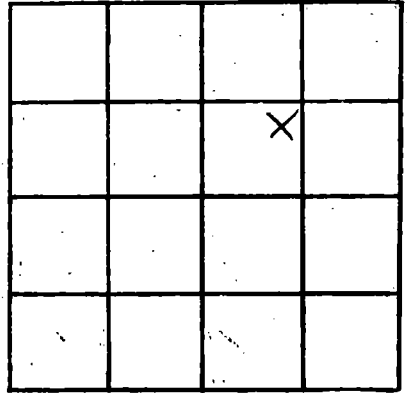

SECTION 22

Please indicate well location X.

ADDITIONAL INFORMATION

If more than one screen, show locations of each on sketch.