

MISSISSIPPI DEPARTMENT OF NATURAL RESOURCES

Bureau of Land and Water Resources

Southport Mall

P.O. Box 10631

Jackson, Mississippi 39209

WATER WELL DRILLERS LOG

COASTAL DRILLING & SERVICE Co. Jackson

Jackson  
82137

6/1/82  
date well completed 19

ROUTE 1 BOX 618

county well located

BILOKI, MISS. 39532

LANDOWNER: John Friedrich  
13505 pine Ave  
Ocean Springs MS  
(mailing address)

description of formations encountered	from to	
top soil	1	3
red clay	3	15
gray sand	15	40
light blue clay	40	45
dark blue clay	40	45
fine water sand	45	48

WELL LOCATION:  
sec 25 T 6 S R 9 E  
1/2 mile (distance) west (direction) of pipeline (nearest town)

WELL PURPOSE: None  
(home, irrigation, municipal, industrial)

WELL COMPLETION DATA:

(1) diameter (inches) 2"

(2) total depth (feet) 440'

(3) static water level (feet) 40' below top of ground

(4) casing PVC (material), 430' (depth)

(size) if telescope see back.

(5) screen 10' (length), 430' (depth to top)

2" (size), PVC (material)

(6) pump 1/2 HP (HP), 13 (yield gpm)

1/2 (type power)

(7) electric log no (yes or no)

(organization running log)


(8) how well bottom plugged  
2' back with gravel

DRILLERS REMARKS: 19-13

DEPT. OF NATURAL RESOURCES  
BUREAU OF LAND & WATER RESOURCES  
NOV 30 1982  
RECEIVED

If well telescopes please sketch and show depths.

GROUND LEVEL

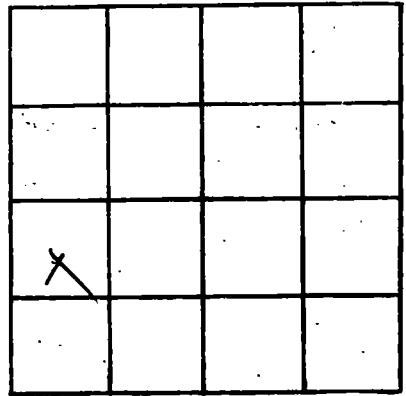

SECTION \_\_\_\_\_

Please indicate well location X.

ADDITIONAL INFORMATION

If more than one screen,  
show locations of each on sketch.