

MISSISSIPPI DEPARTMENT OF NATURAL RESOURCES

Bureau of Land and Water Resources

Southport Mall

P.O. Box 10631

Jackson, Mississippi 39209

WATER WELL DRILLERS LOG

COASTAL DRILLING & SERVICE CO.

ROUTE 1 BOX 618

firm name

BILOXI, MISS 39532

county well located

Jackson
82138

10/12/82
date well completed

Jackson

LANDOWNER: George Cantel

description of formations encountered

from to

Seamon Rd

top soil

6 3

Ocean Spring Man

red clay

5 15

(mailing address)

green sand

15 60

WELL LOCATION:

sec 31 T 6 R 2 E

soft blue clay

60 70

1/2 mile South

fine water sand

70 210

(distance) (direction) (nearest town)

soft blue clay

210 230

WELL PURPOSE: home
(home, irrigation, municipal, industrial)

hard blue clay

230 320

WELL COMPLETION DATA:

fine water sand

320 410

(1) diameter (inches) 2"

hard blue clay

410 440

(2) total depth (feet) 690'

fine water sand

440 455

(3) static water level (feet) 45' below top of ground.

good water sand

455 660

(4) casing PVC 680'
(material) (depth)

good water sand

660 690

(size) if telescope see back.

(5) screen 10' 680'
(length) (depth to top)

2" PVC
(size) (material)

(6) pump None 13
(HP) (yield gpm)

4ll
(type power)

(7) electric log No
(yes or no)

(organization running log)

(8) how well bottom plugged
2' back with sludge

DRILLERS REMARKS:


DEPT. OF NATURAL RESOURCES
BUREAU OF LAND & WATER RESOURCES

NOV 30 1982

RECEIVED

If well telescopes please sketch and show depths.

GROUND LEVEL

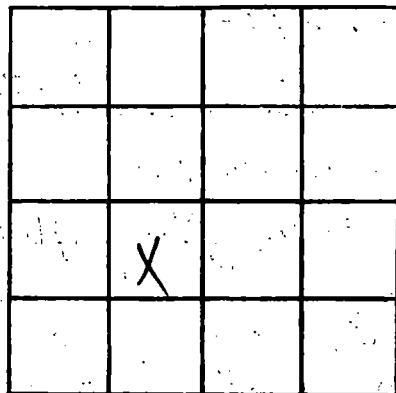

SECTION _____

Please indicate well location X.

ADDITIONAL INFORMATION

If more than one screen, show locations of each on sketch.