

MISSISSIPPI DEPARTMENT OF NATURAL RESOURCES

Bureau of Land and Water Resources

Southport Mall

P.O. Box 10631

Jackson, Mississippi 39209

WATER WELL DRILLERS LOG

Jackson
 9 2139

Oct. 22 1982
 date well completed

Duncan Well Drilling
 firm name

Jackson
 county well located

LANDOWNER: Charles Mc Morrow
9229 Cortwright Lane
N. Biloxi Ms. 39532
 (mailing address)

description of formations encountered

from

to

WELL LOCATION:
 sec 23 T 6 N R 9 E
6 miles (distance) N (direction) of Ocean Springs (nearest town)

Sand	0	80
Sand & Clay mixed	80	200
Blue clay	200	243
Blue white sand mixed	243	360
fine sand	360	425
Course sand	425	450

WELL PURPOSE: Home
 (home, irrigation, municipal, industrial)

WELL COMPLETION DATA:

- (1) diameter (inches) 2"
- (2) total depth (feet) 450
- (3) static water level (feet) 20' below top of ground.
- (4) casing PVC (material), 440 (depth)
- (size) If telescope see back.
- (5) screen 10' (length), 440 (depth to top)
- 2" (size), PVC (material)
- (6) pump (HP) (yield gpm)
- (type power)
- (7) electric log (yes or no)

(organization running log)

(8) how well bottom plugged Sand
Shale

DRILLERS REMARKS: Owner installed his own pump


DEPT. OF NATURAL RESOURCES
 BUREAU OF LAND & WATER RESOURCES

JAN 21 1983

RECEIVED

If well telescopes please sketch and show depths.

GROUND LEVEL

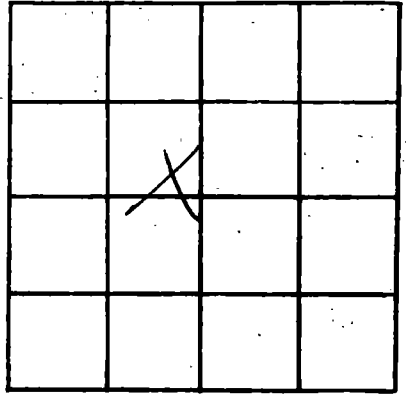

SECTION 23

Please indicate well location X.

ADDITIONAL INFORMATION

If more than one screen show locations of each on sketch.