

MISSISSIPPI DEPARTMENT OF NATURAL RESOURCES

Bureau of Land and Water Resources

Southport Mall

P.O. Box 10631

Jackson, Mississippi 39209

WATER WELL DRILLERS LOG

Jackson
82140

11-2-82 19
date well completed

Coast Water Well Sew.
firm name

Jackson
county well located

LANDOWNER

Timothy Steun

8000 Stone Ranch Rd.

Ocean Springs, Miss.
(mailing address) *39524*

WELL LOCATION:

sec *26* T *6* R *8*
4 miles *SW* of *Vandover*
(distance) (direction) (nearest town)

WELL PURPOSE:

Home
(home, irrigation, municipal, industrial)

WELL COMPLETION DATA:

- (1) diameter (inches) *2"*
- (2) total depth (feet) *70'*
- (3) static water level (feet) *30'* below top of ground.
- (4) casing *PVC*, *60'*
(material) (depth)
2"
(size) If telescope see back.
- (5) screen *10'*, *60'*
(length) (depth to top)
2", *PVC*
(size) (material)
- (6) pump *1 hp.*, *10*
(HP) (yield gpm)
Elect.
(type power)
- (7) electric log *No*
(yes or no)

(organization running log)

description of formations encountered

description of formations encountered	from	to
<i>Top soil</i>	<i>0</i>	<i>5'</i>
<i>R. Clay</i>	<i>5'</i>	<i>24'</i>
<i>M. Sand</i>	<i>24'</i>	<i>70'</i>

DEPT. OF NATURAL RESOURCES
BUREAU OF LAND & WATER RESOURCES

DEC 31 1982


RECEIVED

DRILLERS REMARKS:

Back work done

If well telescopes please sketch and show depths.

GROUND LEVEL

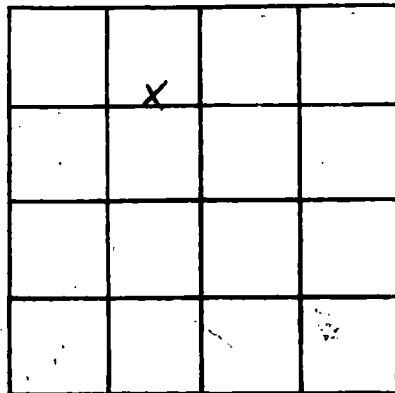

SECTION 25

Please indicate well location X.

ADDITIONAL INFORMATION

If more than one screen, show locations of each on sketch.