

MISSISSIPPI DEPARTMENT OF NATURAL RESOURCES

Bureau of Land and Water Resources

Southport Mall

P.O. Box 10631

Jackson, Mississippi 39209

WATER WELL DRILLERS LOG

Jackson
82141

11-2-1982 date well completed
82 Coast Water Well Sew. firm name
Jackson county well located

LANDOWNER

Stanley D. Brookline

Description of formations encountered

from

to

Rt 6-10505 Hwy Beyond

Top. soil

0

3'

Ocean Springs Miss.
(mailing address) 39163

R. Clay

3'

22'

WELL LOCATION:

sec 26 T 6 N R 8 E
4 miles SW of Vardian
(distance) (direction) (nearest town)

M. Sand

22'

68'

WELL PURPOSE:

Home
(home, irrigation, municipal, industrial)

WELL COMPLETION DATA:

- (1) diameter (inches) 2"
- (2) total depth (feet) 68'
- (3) static water level (feet) 20' below top of ground.
- (4) casing PVC, 58' (material), (depth)
2" (size) if telescope see back.
- (5) screen 10' (length), 58' (depth to top)
2" (size), PVC (material)
- (6) pump (HP) (yield gpm)
Elex. (type power)
- (7) electric log No (yes or no)
(organization running log)

DEPT. OF NATURAL RESOURCES
BUREAU OF LAND & WATER RESOURCES

DEC 31 1982


RECEIVED

DRILLERS REMARKS:

new well bottom plugged
back wash valve

If well telescopes please sketch and show depths.

GROUND LEVEL

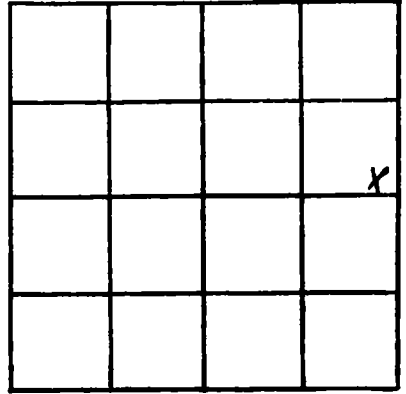

SECTION 26

Please indicate well location X.

ADDITIONAL INFORMATION

If more than one screen, show locations of each on sketch.