

MISSISSIPPI DEPARTMENT OF NATURAL RESOURCES

Bureau of Land and Water Resources

Southport Mall

P.O. Box 10631

Jackson, Mississippi 39209

WATER WELL DRILLERS LOG

Jackson
92143

Nov. 18 1982
date well completed

82 Nuncom Well Drilling
firm name

Jackson
county well located

LANDOWNER: Sammy Woods
Rt. 1 Box 180-B
Deer Springs Ms.
(mailing address)

description of formations encountered	from	to
	<u>sand</u>	<u>0</u>
<u>clay</u>	<u>90</u>	<u>210</u>
<u>fine sand</u>	<u>210</u>	<u>250</u>
<u>Blue Clay</u>	<u>250</u>	<u>350</u>
<u>fine sand</u>	<u>350</u>	<u>429</u>
<u>course sand</u>	<u>429</u>	<u>484</u>

WELL LOCATION:
sec 23 T 6 N R 9 E
8 miles N of Deer Springs
(distance) (direction) (nearest town)

WELL PURPOSE: Home
(home, irrigation, municipal, industrial)


- WELL COMPLETION DATA:
- (1) diameter (inches) 2"
 - (2) total depth (feet) 484 ft.
 - (3) static water level (feet) 40 below above top of ground.
 - (4) casing PVC 474
(material) (depth)
 - (size) If telescope see back.
 - (5) screen 10' 474'
(length) (depth to top)
 - 2" PVC
(size) (material)
 - (6) pump _____ (HP) _____ (yield gpm)
 - (type power) _____
 - (7) electric log _____ (yes or no)
 - (organization running log) _____
 - (8) how well bottom plugged _____

DRILLERS REMARKS: Owner had his own pump & installed it.

DEPT. OF NATURAL RESOURCES
BUREAU OF LAND & WATER RESOURCES
JAN 21 1983
RECEIVED

If well telescopes please sketch and show depths.

GROUND LEVEL

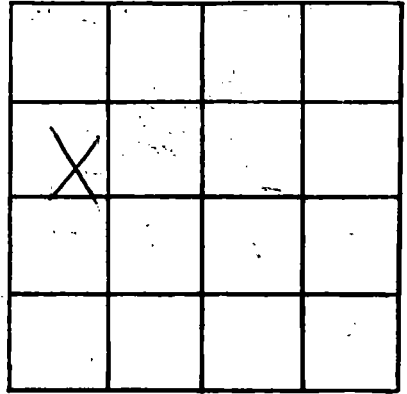

SECTION 23

Please indicate well location X.

ADDITIONAL INFORMATION

If more than one screen, show locations of each on sketch.