

MISSISSIPPI DEPARTMENT OF NATURAL RESOURCES

Bureau of Land and Water Resources

Southport Mall

P.O. Box 10631

Jackson, Mississippi 39209

WATER WELL DRILLERS LOG

Jackson  
J 2144

12-8-82 19  
date well completed

Coast Water Well Sew. Jackson  
firm name county well located

LANDOWNER: Alton Delancey

Description of formations encountered

from

to

6600 Clark St.

Top soil

0 3'

Mass Point, Miss.  
(mailing address) 35563

Red clay

3' 24'

WELL LOCATION:

sec 14 T 6 R 8  
4 miles SW of LANCLEASE  
(distance) (direction) (nearest town)

M. sand

24' 65'

WELL PURPOSE:

(home, irrigation, municipal, industrial)

Home

WELL COMPLETION DATA:

- (1) diameter (inches) 2"
- (2) total depth (feet) 65'
- (3) static water level (feet) 24' below above top of ground.
- (4) casing PVC, 55'  
(material) (depth)  
2"  
(size) if telescope see back.
- (5) screen 10', 55'  
(length) (depth to top)  
2" PVC  
(size) (material)
- (6) pump 1/2 H.P., 13  
(HP) (yield gpm)  
Elect.  
(type power)
- (7) electric log No.  
(yes or no)

(organization running log)

(8) how well bottom plugged  
Backwash Valve

DRILLERS REMARKS:


DEPT. OF NATURAL RESOURCES  
BUREAU OF LAND & WATER RESOURCES

JAN 11 1983

RECEIVED

If well telescopes please sketch and show depths.

GROUND LEVEL

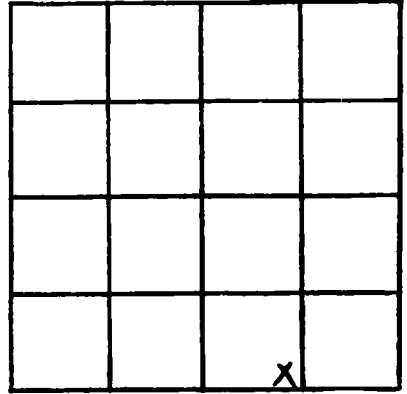

SECTION \_\_\_\_\_

Please indicate well location X.

ADDITIONAL INFORMATION

If more than one screen, show locations of each on sketch.