

MISSISSIPPI DEPARTMENT OF NATURAL RESOURCES

Bureau of Land and Water Resources

Southport Mall

P.O. Box 10631

Jackson, Mississippi 39209

WATER WELL DRILLERS LOG

*Jackson*  
*92146*

*12-30-*  
date well completed

*St. Coast Water Well Sew. Jackson*  
firm name

county well located

LANDOWNER: *Cheryl Loney*

description of formations encountered

from to

*Rt 3-Box 144-A*  
*Biola, Miss.*  
(mailing address)

<i>Top soil</i>	<i>0</i>	<i>2'</i>
<i>Red coarse sand</i>	<i>2</i>	<i>27'</i>
<i>Blue clay</i>	<i>27'</i>	<i>172'</i>
<i>Gray coarse sand</i>	<i>172'</i>	<i>179'</i>
<i>Blue clay</i>	<i>179'</i>	<i>213'</i>
<i>Gray coarse sand</i>	<i>213'</i>	<i>244'</i>

WELL LOCATION:

sec *34* T *6* N R *9* E  
S W  
*3 1/2* miles *S* of *LATIMER*  
(distance) (direction) (nearest town)

WELL PURPOSE: *Home*  
(home, irrigation, municipal, industrial)

WELL COMPLETION DATA:

- (1) diameter (inches) *2"*
- (2) total depth (feet) *244'*
- (3) static water level (feet) *27'* below above top of ground.
- (4) casing *PVC*, *234'*  
(material) (depth)
- 2"*  
(size) if telescope see back.
- (5) screen *10'*, *234'*  
(length) (depth to top)
- 2"*, *PVC*  
(size) (material)
- (6) pump *1 hp*, *1 1/2*  
(HP) (yield gpm)
- Elect.*  
(type power)
- (7) electric log *No.*  
(yes or no)
- (organization running log)

(8) how well bottom plugged *back wash valve*

DRILLERS REMARKS:


DEPT. OF NATURAL RESOURCES  
BUREAU OF LAND & WATER RESOURCES

JAN 11 1988

RECEIVED

If well telescopes please sketch and show depths.

GROUND LEVEL

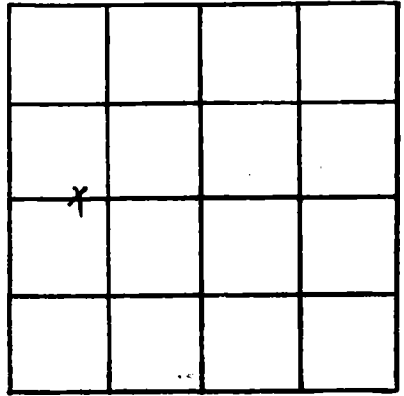

SECTION 34

Please indicate well location X.

ADDITIONAL INFORMATION

If more than one screen,  
show locations of each on sketch.