

MISSISSIPPI DEPARTMENT OF NATURAL RESOURCES

Bureau of Land and Water Resources

Southport Mall

P.O. Box 10631

Jackson, Mississippi 39209

WATER WELL DRILLERS LOG

Jackson
J 2147

3-21-83

19 Coast Water Well Serv.

Jackson

date well completed

firm name

county well located

LANDOWNER: Steve Mallett
12100 Old Fort Bayou Rd.
Ocean Springs, Miss.
(mailing address) 39564

description of formations encountered	from	to
Top soil	0	5'
Red Clay	5'	14'
Red Coarse Sand	14'	65'
White Clay	65'	80'
Blue Clay	80'	100'
Blue Clay & Shud/sand	100'	171'
Blue Clay	171'	189'
Gray Coarse sand	189'	221'
Blue Clay	221'	279'
Blue Clay & Shud/sand	279'	295'
Blue Clay	295'	330'
Blue Clay & Shud/sand	330'	362'
Blue Clay	362'	370'
Gray Coarse sand	370'	416'

WELL LOCATION:
sec 13 T 6 S R 8 E
3 1/2 miles SW of VAN CLEAVE
(distance) (direction) (nearest town)

WELL PURPOSE: None
(home, irrigation, municipal, industrial)

WELL COMPLETION DATA:

(1) diameter (inches) 2"

(2) total depth (feet) 416'

(3) static water level (feet) 65' below above top of ground.

(4) casing PVC 406'
(material) (depth)
2" If telescope see back.
(size)

(5) screen 10' 406'
(length) (depth to top)
2" PVC
(size) (material)

(6) pump 1 1/2 HP 6 1/2
(HP) (yield gpm)
Elect.
(type power)

(7) electric log No.
(yes or no)

(organization running log)

(8) how well bottom plugged Back wash valve

DRILLERS REMARKS:


DEPT. OF NATURAL RESOURCES
BUREAU OF LAND & WATER RESOURCES

APR 28 1983

RECEIVED

If well telescopes please sketch and show depths.

GROUND LEVEL

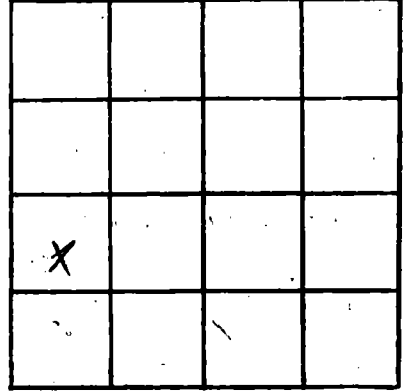

SECTION 13

Please indicate well location X.

ADDITIONAL INFORMATION

Lined area for additional information.

If more than one screen, show locations of each on sketch.