

MISSISSIPPI DEPARTMENT OF NATURAL RESOURCES

DEPT. OF NATURAL RESOURCES
BUREAU OF LAND & WATER RESOURCES

Bureau of Land and Water Resources

Southport Mall

P.O. Box 10631

Jackson, Mississippi 39209

WATER WELL DRILLERS LOG

Jackson
JUL 27 1983
52148

RECEIVED


Water Well Sew. Jackson
date well completed 6-1-83 1983 firm name county well located

LANDOWNER:	description of formations encountered	from	to
<i>P.L. Williams</i>	<i>Top soil</i>	<i>0'</i>	<i>5'</i>
<i>Rt. 6-Box 349</i>	<i>Red Clay</i>	<i>5'</i>	<i>40'</i>
<i>Ocean Springs, Miss.</i>	<i>Red Coarse sand</i>	<i>40'</i>	<i>65'</i>
(mailing address) <i>32564</i>	<i>White Clay</i>	<i>65'</i>	<i>80'</i>
WELL LOCATION:	<i>Blue Clay</i>	<i>80'</i>	<i>150'</i>
sec. <i>14</i> T. <i>6</i> S. R. <i>8</i> W.	<i>White Coarse sand</i>	<i>150'</i>	<i>183'</i>
<i>4/4</i> miles W of <i>VANCELAKE</i>	<i>Blue Clay</i>	<i>183'</i>	<i>205'</i>
(distance) (direction) (nearest town)	<i>Gray Coarse sand</i>	<i>205'</i>	<i>230'</i>
WELL PURPOSE: <i>Home</i>	<i>Blue Clay</i>	<i>230'</i>	<i>287'</i>
(home, irrigation, municipal, industrial)	<i>Struck 7 sand</i>	<i>287'</i>	<i>290'</i>
WELL COMPLETION DATA:	<i>Blue Clay</i>	<i>290'</i>	<i>345'</i>
(1) diameter (inches) <i>2"</i>	<i>Gray med. sand</i>	<i>345'</i>	<i>365'</i>
(2) total depth (feet) <i>431'</i>	<i>Blue Clay</i>	<i>365'</i>	<i>375'</i>
(3) static water level (feet) <i>68'</i> below top of ground.	<i>Gray med sand</i>	<i>375'</i>	<i>387'</i>
(4) casing <i>PVC</i> <i>421'</i> (material) (depth)	<i>Blue Clay</i>	<i>387'</i>	<i>415'</i>
<i>2"</i> (size) if telescope see back.	<i>Gray Coarse sand</i>	<i>415'</i>	<i>431'</i>
(5) screen <i>10'</i> <i>421'</i> (length) (depth to top)			
<i>2"</i> (size) <i>PVC</i> (material)			
(6) pump (HP) (yield gpm)			
<i>Elect.</i> (type power)			
(7) electric log <i>No.</i> (yes or no)			
(organization running log)			
(8) how well bottom plugged <i>Backwash</i>			
<i>Value</i>			

DRILLERS REMARKS:

If well telescopes please sketch and show depths.

GROUND LEVEL

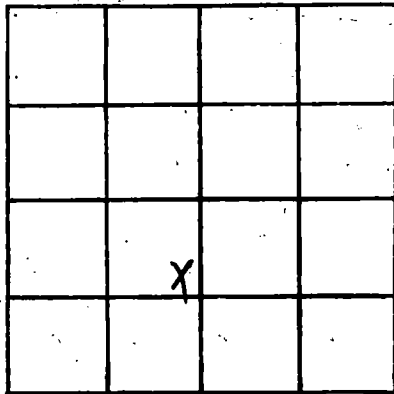

SECTION 14

Please indicate well location X.

ADDITIONAL INFORMATION

If more than one screen, show locations of each on sketch.